IREDELL COUNTY HEALTH DEPARTMENT - *ENVIRONMENTAL HEALTH* ☐ STATESVILLE OFFICE 704-878-5305 ☒ MOORESVILLE OFFICE 704-664-5281

IMPROVEMENT PERMIT / AUTHORIZATION TO CONSTRUCT / OPERATION PERMIT / EXISTING SYSTEM INSPECTION

PERMIT # 168629 PIN # 4625-47-6060 DATE 10-3-11

OWNER JOHN DOLL APPLICANT: SAME PHONE: Home/Cell # 704-658-2358 Business #

SITE ADDRESS 300 LAKEMIST DR. OWNER / APPLICANT ADDRESS SAME

SITE DIRECTIONS BSR, TR HARBOR, TL LAKE MIST, C END

SUBDIVISION THE HARBOUR BLOCK / SECTION LOT # 21 LOT AREA .77AC DESIGN FLOW 480 L.T.A.R. 13

Septic Tank Ex. 1000 Gallons: STB Date

Pump Tank Ex. 1000 Gallons: PT Date

Pump Make HYDROMATIC Model SHEFSOM 1 Serial #

No. Nitrification Fields: No. Lines Linear Feet

Trench Width EXISTING Max Trench Bottom Depth Gravel Depth

☐ New System ☐ Repair ☐ Expansion System Type I II (III) IV V VI

System Description: PM - 25% RED. 5

Repair System Description: LP - PANEL

Maintenance Agreement Required ☐ YES ☒ NO INITIALLY

☐ GRAVITY ☒ PRESSURE


☒ Residence No. Bedrooms 4 ☐ Business No. Persons ☒ Other No. Employees ☐ Slab ☒ Crawl Space ☒ Basement w/plumbing ☐ Basement w/o plumbing

Water Supply: ☐ Private ☐ Public ☒ Community


Comments / Conditions ① GARAGE MUST BE 5' MIN FROM SEPTIC

GARAGE EXTENSION

INITIAL SITE SKETCH

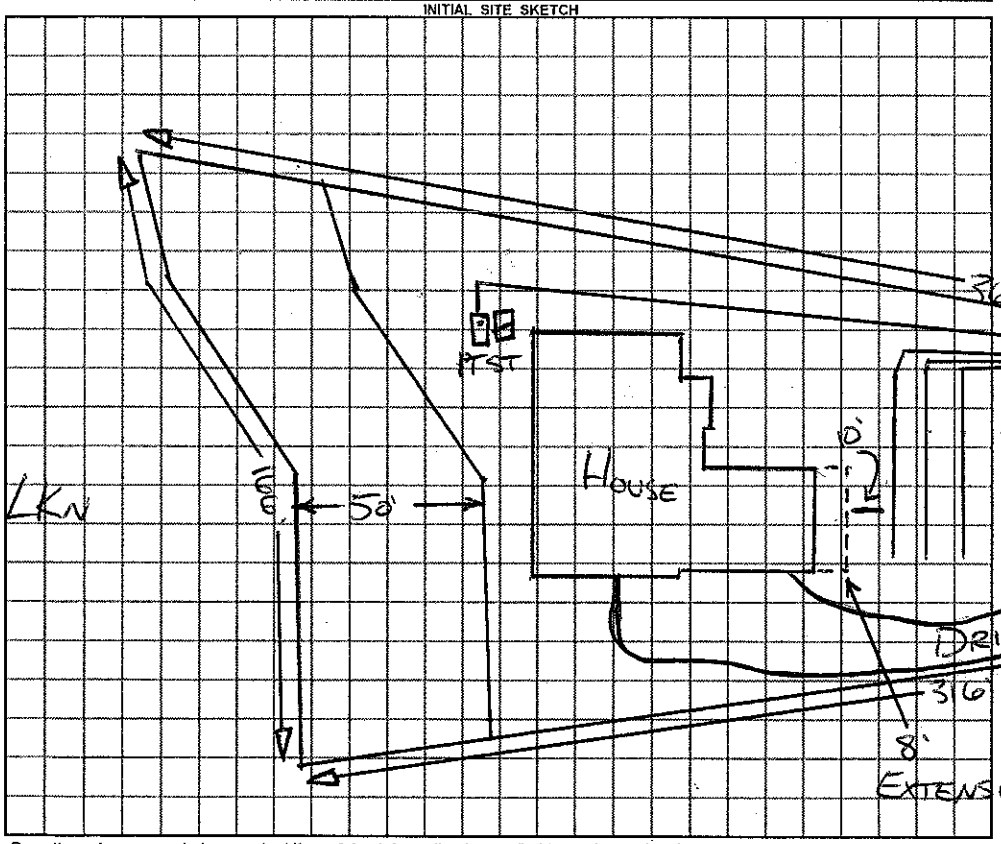

AS BUILT SKETCH

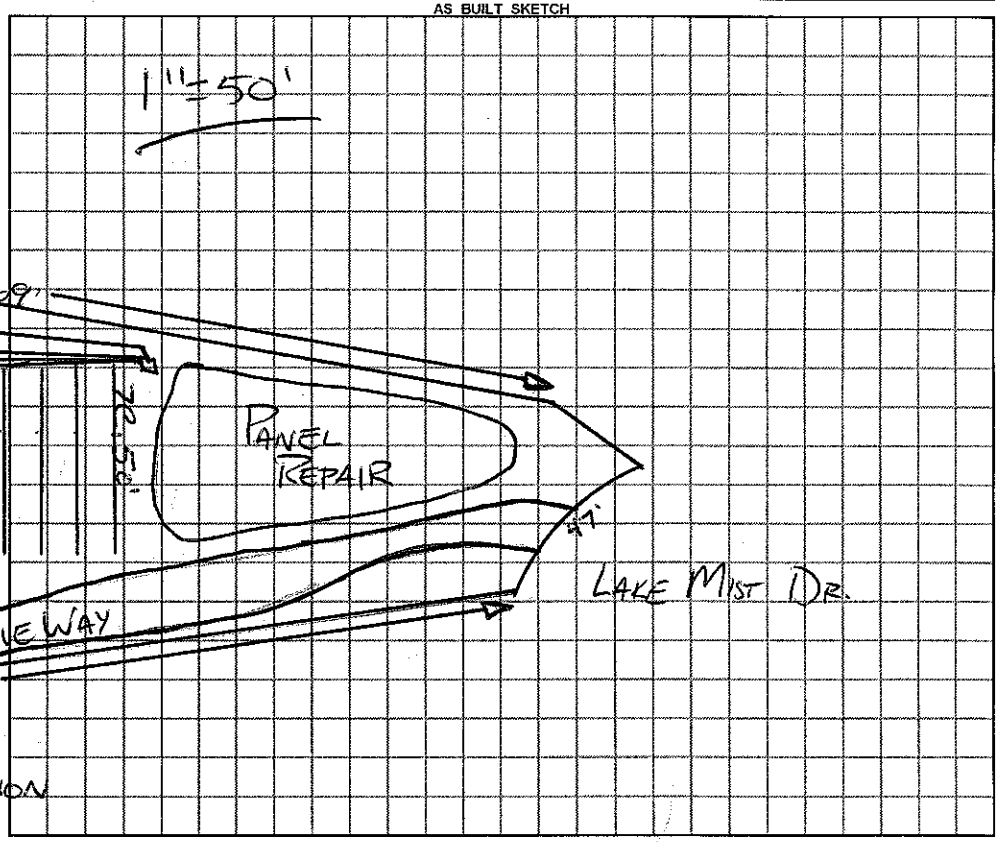

Permit can be suspended or revoked if any false information is supplied toward securing the permit / any unauthorized changes are made to the site / any unauthorized changes are made in the installation of the system.

☐ ***IMPROVEMENT PERMIT*** with plat valid without expiration. ☐ ***IMPROVEMENT PERMIT*** with plat valid without expiration. site plan valid 60 mo. ☐ ***AUTHORIZATION TO CONSTRUCT*** valid for period equal to IMPROVEMENT PERMIT--not to exceed 60 mo.

Owner / Applicant Signature: John Doll Date 10/04/11 Installed by:

IMPROVEMENT PERMIT by: REHS Date OPERATION PERMIT by: REHS Date

AUTHORIZATION TO CONSTRUCT by: REHS Date ting System Inspected by: REHS Date 10-3-11

YOU SHOULD CONTACT A LOCATOR SERVICE PRIOR TO ANY EXCAVATION

Copy – Environmental Health YELLOW COPY (Final) Owner / Applicant PINK COPY (Initial) Owner / Applicant