IREDELL COUNTY HEALTH DEPARTMENT

STATESVILLE 704-878-5305 MOORESVILLE 704-664-5281

IMPROVEMENT PERMIT / AUTHORIZATION TO CONSTRUCT / OPERATION PERMIT / EXISTING SYSTEM INSPECTION

PERMIT# 025780 PIN# ~~4625-43-2643~~ 4625-47-6612 DATE 11/25/98

OWNER OR CONTRACTOR M/I HOMES - CRESCENT PHONE: Business 463-6905 - JACOBS Home

ADDRESS 1043 E. Morehead St. Charlotte, NC.

LOCATION Brawley School TR Bay Harbor Tl Lake West TR Silver Eagle at end.

SUBDIVISION HARBOUR BLOCK / SECTION 4 LOT 30 LOT AREA 32176 FT² SITE CLASS. PS DESIGN FLOW 480 L.T.A.R. .3

Septic Tank: 1000 Gallons; STB 794 Date 11/19/99

Pump Tank: 1000 Gallons; PT 27 Date 2/3/99

Pump Make: HYDROMATIC Model SK 600 Serial No. 1/99

Nitrification Field: No Fields 1 Square Feet 798 Linear Feet 266

No Lines 5 Trench Width 36" Max Trench Bottom Depth 36" Gravel Depth SAND.

☒ New System ☐ Repair System Type: I, II, III, ⓘ V, VI

System Description: Pressure - 16" PPBS

Repair System Description: 16" PPBS

Maintenance Agreement Required: ☒ Yes ☐ No

☒ House/Mod. Home No. Bedrooms 4

☐ Mobile Home No. Bathrooms 4

☐ Business No. Employees

☐ Other


☐ Slab ☐ Crawl Space ☐ Basement w/plumbing ☐ Basement wo/plumbing

Water Supply: ☐ Individual ☒ Public ☐ Community


Comments:/Conditions:

Comments:/Conditions: 5/17/99 Front yard has been heavily graded and compacted.

INITIAL SITE SKETCH

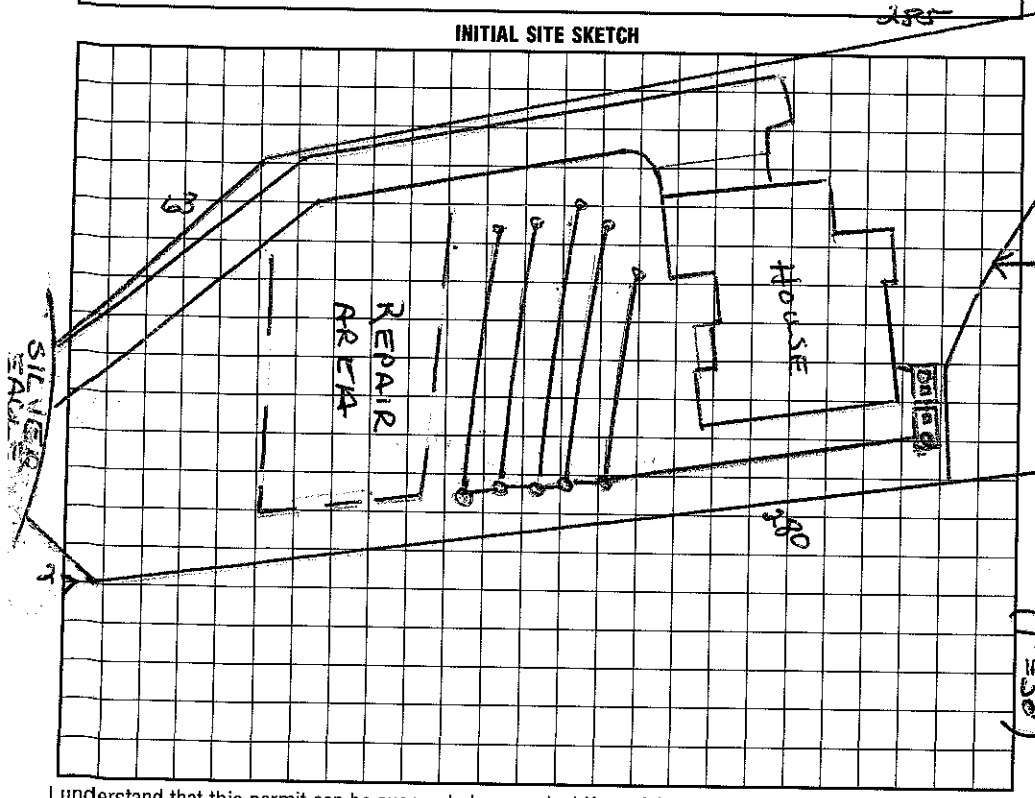

AS BUILT SKETCH

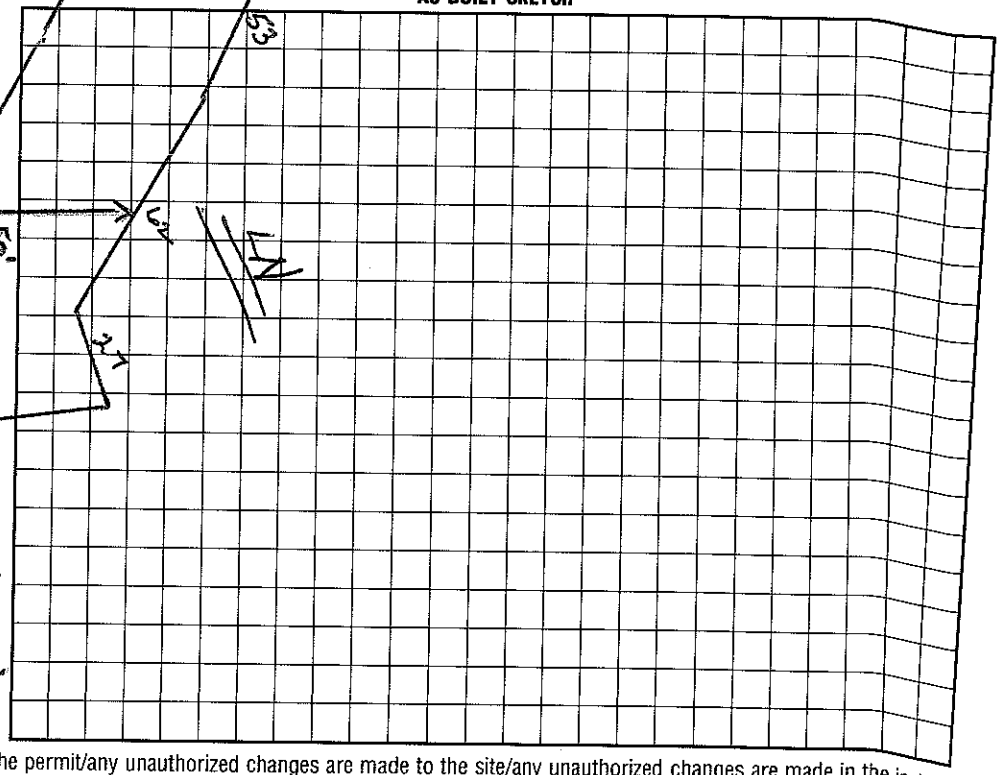

I understand that this permit can be suspended or revoked if any false information is supplied toward securing the permit/any unauthorized changes are made to the site/any unauthorized changes are made in the installation of the system. Improvement Permit with plat valid without expiration. Improvement Permit with site plan valid for sixty months. Authorization to Construct is valid for a period equal to that of Improvement Permit – not to exceed sixty months.

Signed: X [signature] Agent date 12/1/98

Improvement Permit by: Wesley Sparks R.S. date 11/25/98

Authorization to Construct by: Wesley Sparks R.S. date 11/25/98

Installed by: Morehead Const.

Operation Permit by: Wesley Sparks R.S. date 5/17/99

Existing System Inspection by: date

HEALTH DEPT. COPY: WHITE INSPECTION COPY (FINAL): GREEN OWNER COPY (FINAL): YELLOW INSPECTION COPY (INITIAL): PINK OWNER COPY (INITIAL): GOLD