IREDELL COUNTY HEALTH DEPARTMENT

AUTHORIZATION TO CONSTRUCT 3:00 ~~30~~ ~~5.00~~ $50

STATESVILLE 704-878-5305 MOORESVILLE 704-664-5281

IMPROVEMENT PERMIT / ~~CERTIFICATE OF COMPLETION~~ / OPERATION PERMIT / EXISTING SYSTEM INSPECTION

PROPERTY DESCRIPTION NO. 26258 DATE 4/28/97 TAX MAP NO. 462547685 3 Watershed: ☑

OWNER OR CONTRACTOR MI HOMES (KING) PHONE: Business ______ Home ______

ADDRESS 1043 E MOREHEAD ST @ CHARLOTTE NC

LOCATION BRAWLEY SCHOOL RD - TR BAY HARBOUR - TL LAKE WEST - TR HUNTER SPRING LN 5TH ON LT

SUBDIVISION HARBOUR BLOCK / SECTION II LOT 34 LOT AREA 31,289 ft² SITE CLASS. PS DESIGN FLOW 480 GPD L.T.A.R. .3 GPD/FT²

Septic Tank: 1000 Gallons; STB 744 Date 10/9/97
Pump Tank: 1000 Gallons; PT 27 Date 9/26/97
Pump Make: ______ Model ______ Serial No. ______
Nitrification Field: No Fields 1 Square Feet 1200 Linear Feet 400
No Lines 5 @ 80' Trench Width 36" Max Trench Bottom Depth 36" Gravel Depth N/A

☑ New System ☐ Repair System Type: I, II, (III), IV, V, VI
System Description: PUMP CHAMBER FED OR SIMILAR
Repair System Description: PUMP PANEL
Maintenance Agreement Required: ☐ Yes ☑ No

☑ House/Mod. Home ☐ Mobile Home ☐ Business ☐ Other
No. Bedrooms 4 No. Bathrooms 4 No. Employees ______

Water Supply: ☐ Individual ☑ Community ☐ Public

☐ Slab ☑ Crawl Space ☑ Basement w/plumbing ☑ Basement wo/plumbing

Comments: REVISED 121 Hunter Spring


12/99 - Watershed [illegible]

Comments: (TANKS CHANGED TO LAKE SIDE OF HOUSE.)

Many LINES, TANKS CHECKED 9/3/97
Tire tracks over drainfield.

INITIAL SITE SKETCH 1" = 40'

AS BUILT SKETCH

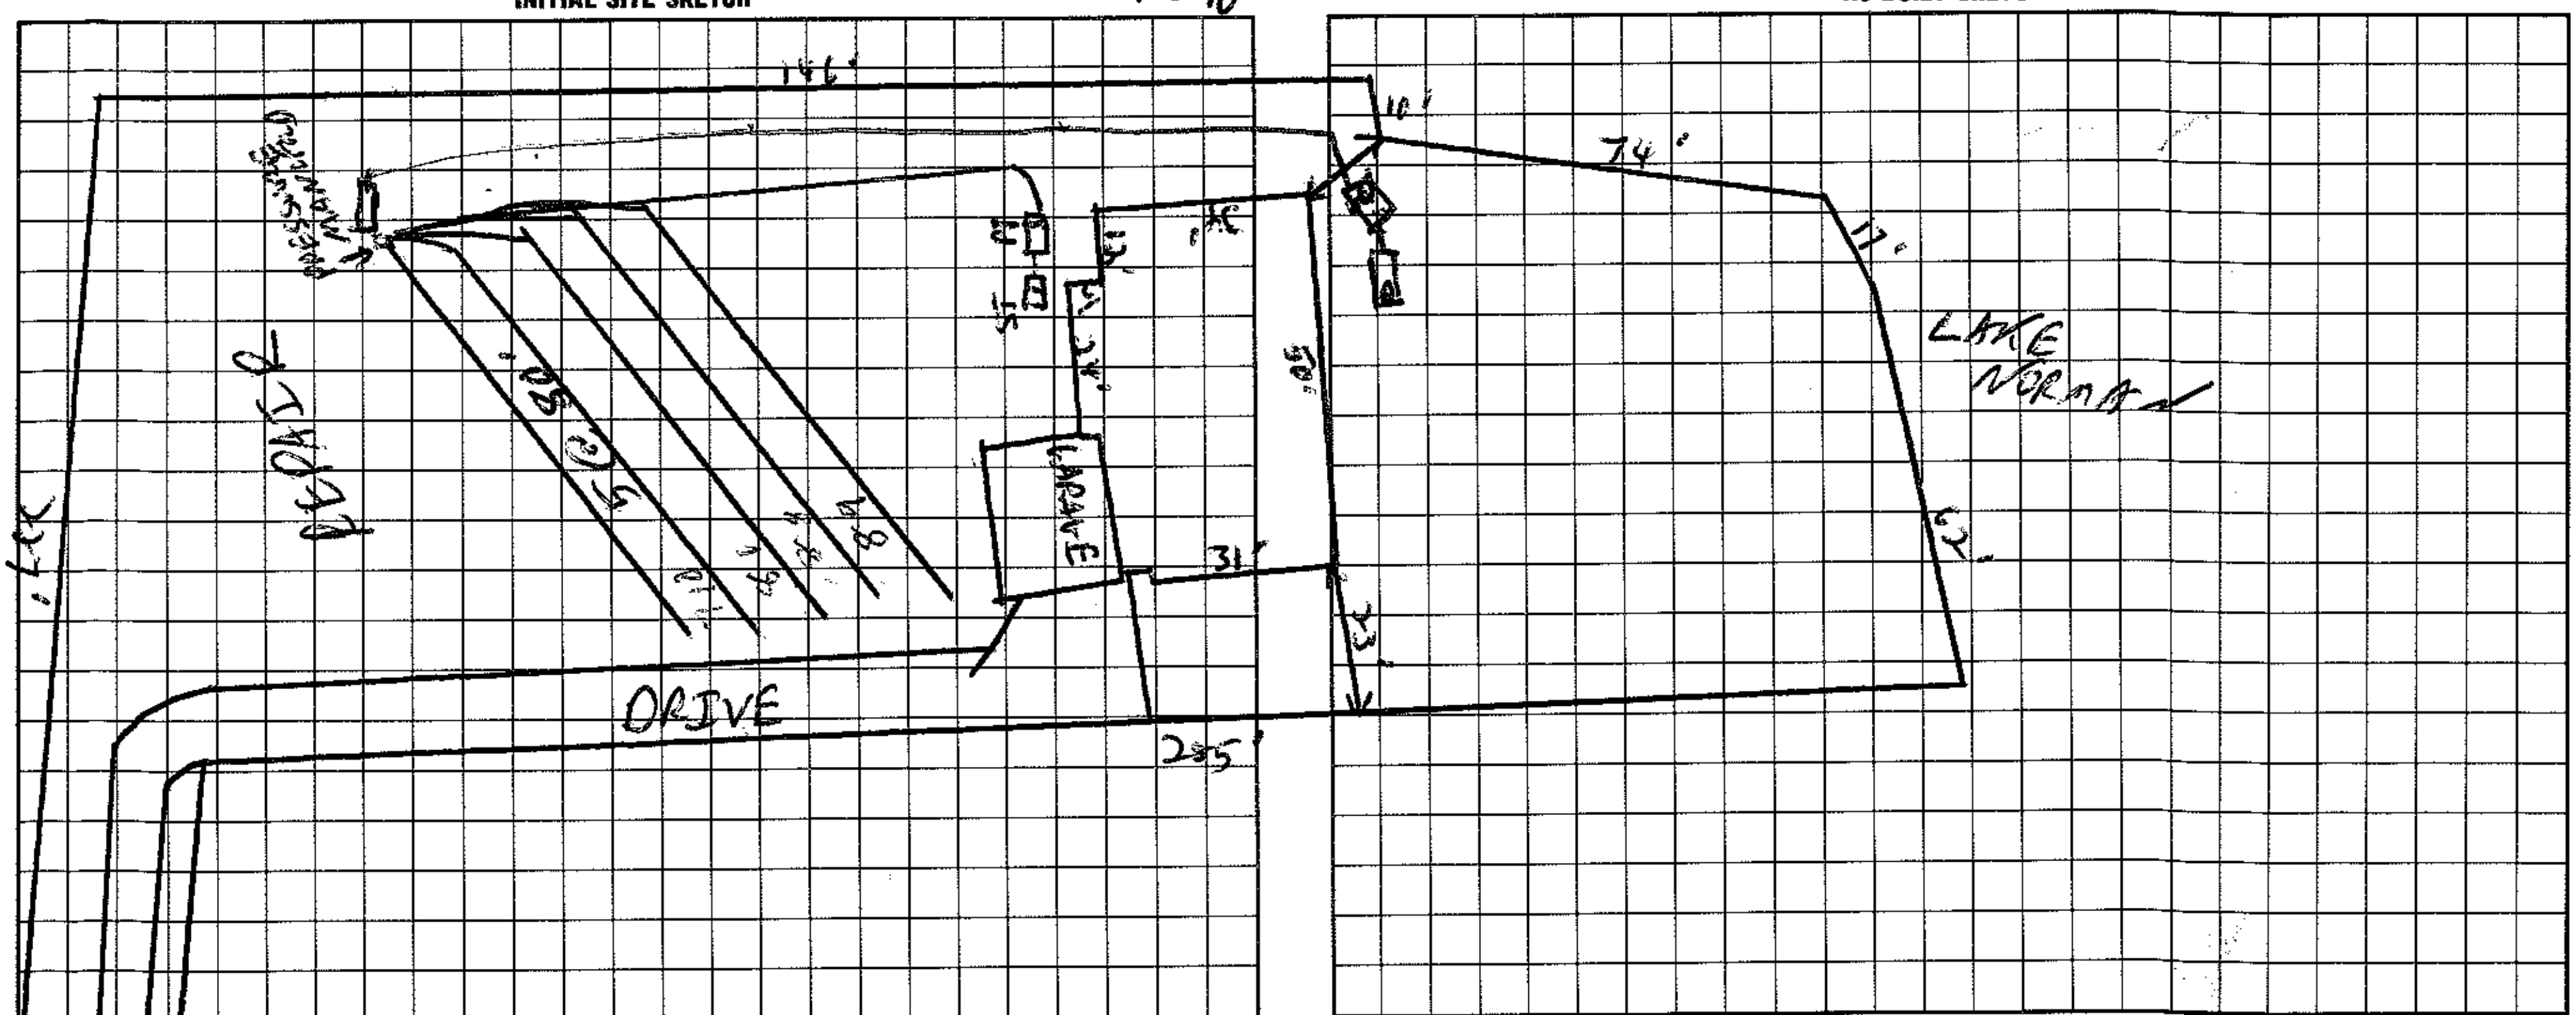

I understand that this permit can be suspended or revoked if any false information is supplied toward securing the permit/any unauthorized changes are made to the site/any unauthorized changes are made in the installation of the system. Improvement Permit is valid for 60 months from date of issuance.

Signed: [signature], Agent

Installed by: McLOED

Improvement Permit by: [signature] date 4/28/97

Certificate of Completion by: [signature] date 10/16/97

AUTHORIZATION TO CONSTRUCT ~~Existing System Inspection by:~~ [signature] date 4/28/97

Operation Permit by: [signature] date 10/16/97

HEALTH DEPT. COPY: WHITE INSPECTION COPY (FINAL): GREEN OWNER COPY (FINAL): YELLOW INSPECTION COPY (INITIAL): PINK OWNER COPY (INITIAL): GOLD