IREDELL COUNTY HEALTH DEPARTMENT

STATESVILLE 704-878-5305 MOORESVILLE 704-66

IMPROVEMENT PERMIT / CERTIFICATE OF COMPLETION / OPERATION PERMIT / EXISTING SYSTEM INSPECTION

PROPERTY DESCRIPTION NO. 21682 DATE Aug 28, 195 TAX MAP NO. part of 2043 4625 47 6953 Watershed: ☑ Yes ☐ No

OWNER OR CONTRACTOR Crescent Resources Corp (M.T. Bowles) PHONE: Business _____ Home _____ W54

ADDRESS PO Box 1093 Charlotte

LOCATION Beaufly Sch Rd. TR Bay Harbour TR LAKE MIST TR ~~Sand Knoll~~ Hunter Spring at end on left

SUBDIVISION The Harbour BLOCK / SECTION _____ LOT 35 LOT AREA ≥ 20,000 ft² SITE CLASS. B per 1956 DESIGN FLOW 480 gpd L.T.A.R. .3

Septic Tank: 1000 Gallons; STB 794 Date 2-24-97

Pump Tank: 1000 Gallons; PT 39 Date 2/27/97

Pump Make: Norweltic Model SHEF 500 Serial No. _____

Nitrification Field: No Fields 1 Square Feet 1200 Linear Feet 400

No Lines Lee 67 Trench Width 36" Max Trench Bottom Depth ≥ 30" Gravel Depth NR

☑ New System ☐ Repair System Type: I, II, III, IV, V, VI

System Description: pumped low pressure infiltration

Repair System Description: LATERALS OF INF.

Maintenance Agreement Required: ☐ Yes ☑ No initially

☐ Slab ☑ Crawl Space ☑ Basement w/plumbing ☐ Basement wo/plumbing

☑ House/Mod. Home No. Bedrooms 4

☐ Mobile Home No. Bathrooms 4

☐ Business No. Employees _____

☐ Other _____


Water Supply:
☐ Individual
☑ Community
☐ Public

Comments: LW 460 Water line can go down right side boundary within 1 foot of pl but must cross on top of septic supply line with at least 18" separation


Comments: DEVELOPER PERMIT PARTIAL

INITIAL SITE SKETCH

1"=50'

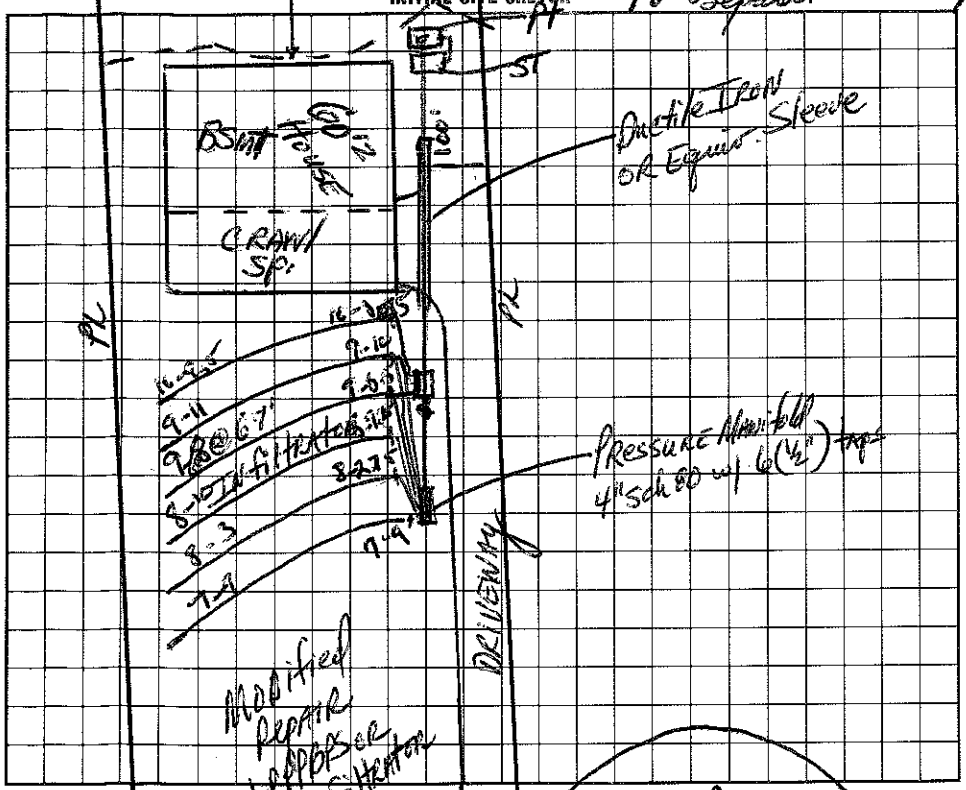

AS BUILT SKETCH

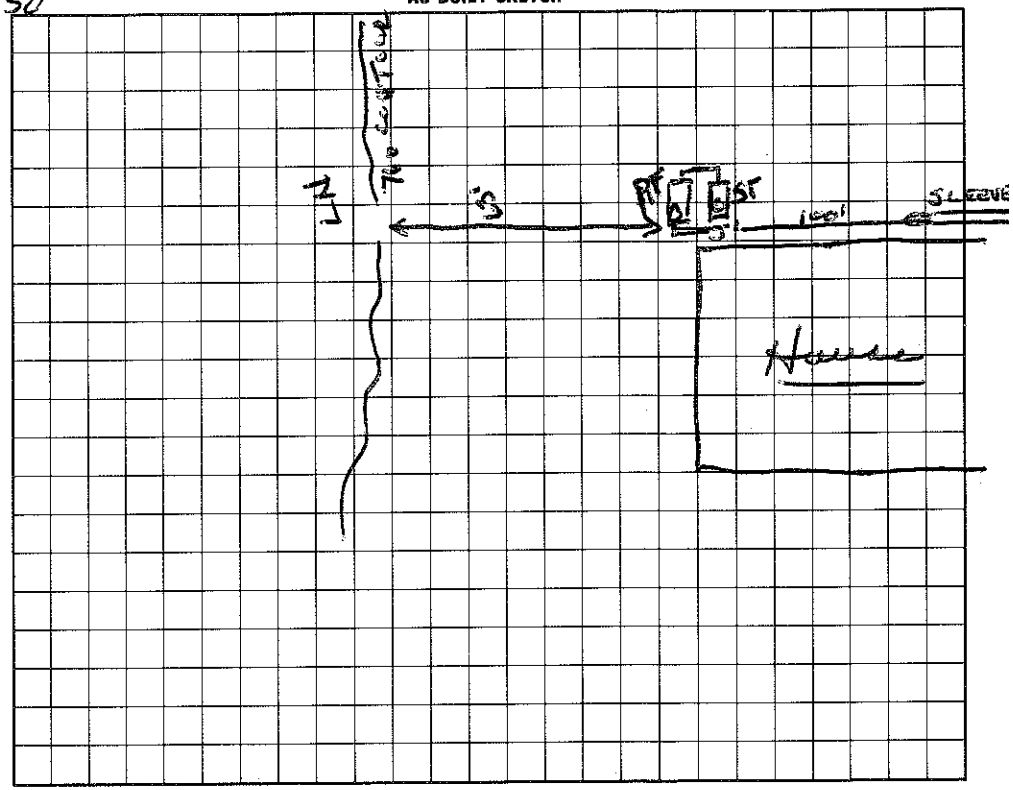

I understand that this permit can be suspended or revoked if any false information is supplied toward securing the permit/any unauthorized changes are made to the site/any unauthorized changes are made in the installation of the system.

Signed: _____

Improvement Permit by: _____ date 8-28-95

Existing System Inspection by: _____ date 11-25-96

Installed by: McLOED

Certificate of Completion by: _____ date _____

Operation Permit by: _____ date 5/20/97

As Built Sketch To Construct

HEALTH DEPT. COPY: WHITE INSPECTION COPY (FINAL): GREEN OWNER COPY (FINAL): YELLOW INSPECTION COPY (INITIAL): PINK OWNER COPY (INITIAL): GOLD