IREDELL COUNTY HEALTH DEPARTMENT

AUTHORIZATION TO CONSTRUCT

STATESVILLE 704-878-5305 MOORESVILLE 704-664-5281

IMPROVEMENT PERMIT / ~~CERTIFICATE OF COMPLETION~~ / OPERATION PERMIT / EXISTING SYSTEM INSPEC

PROPERTY DESCRIPTION NO. 069463 DATE 10/13/97 TAX MAP NO. 4625575666 4625478127 Watershed: ☑ Yes

OWNER OR CONTRACTOR MI HOMES PHONE: Business 663-6905 T. JACOBS Home

ADDRESS 1043 E MOREHEAD ST STE 105 CHARLOTTE

LOCATION BRAWLEY SCHOOL - TR BAY HARBOR - TL LAKEMIST

SUBDIVISION HARBOUR BLOCK / SECTION II LOT 23 LOT AREA SITE CLASS. RS DESIGN FLOW 450 L.T.A.R. .3

Septic Tank: 1000 Gallons; STB 794 Date 5/30/99

Pump Tank: 1000 Gallons; PT 2M Date 5/22/99

Pump Make: HYDROMATIC Model SHEF50A Serial No. 5/06/99

Nitrification Field: No Fields 1 Square Feet 1200 Linear Feet 400

No Lines 5@50' Trench Width 36" Max Trench Bottom Depth 36" Gravel Depth N/A

☑ New System ☐ Repair System Type: I, II, III, IV, V, VI

System Description: PUMP CHAMBERED OR HDS

Repair System Description: PUMP PANEL

Maintenance Agreement Required: ☐ Yes ☑ No

☑ House/Mod. Home No. Bedrooms 4

☐ Mobile Home No. Bathrooms 4

☐ Business No. Employees

☐ Other

☐ Slab ☑ Crawl Space ☑ Basement w/plumbing ☐ Basement wo/plumbing


Water Supply:
☐ Individual
☑ ~~Community~~
☐ Public

Comments:

Comments: PARTIAL BASEMENT

LAKEMIST

INITIAL SITE SKETCH

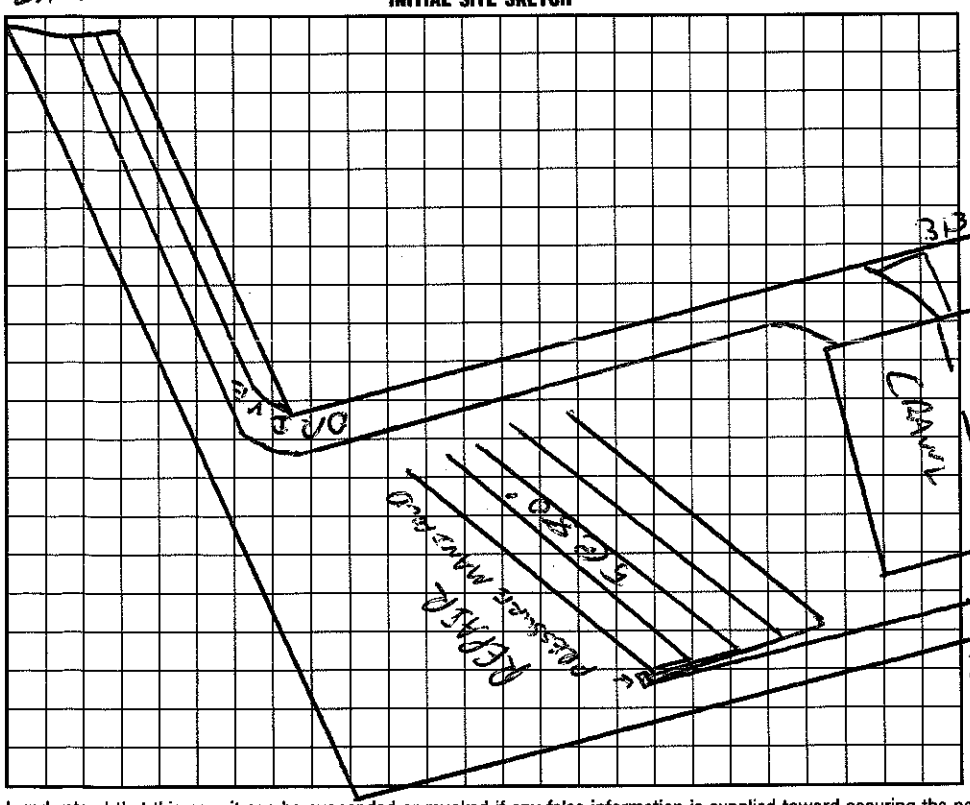

AS BUILT SKETCH

I understand that this permit can be suspended or revoked if any false information is supplied toward securing the permit/any unauthorized changes are made to the site/any unauthorized changes are made in the installation of the system. Improvement Permit is valid for 60 months from date of issuance.

Signed: Tony C Jacobs 10-24-97 Installed by: MacLeod Const.

Improvement Permit by: C. W. Freeman date 10/13/97 Certificate of Completion by: Wesley Sparks RS. date 9/8/99

~~Existing System Inspection by:~~ AUTHORIZATION TO CONSTRUCT C. W. Freeman date 10/13/97 Operation Permit by: Wesley Sparks RS. date 9/8/99

HEALTH DEPT. COPY: WHITE INSPECTION COPY (FINAL): GREEN OWNER COPY (FINAL): YELLOW INSPECTION COPY (INITIAL): PINK OWNER COPY (INITIAL): GOLD