# IREDELL COUNTY HEALTH DEPARTMENT

AUTHORIZATION TO CONSTRUCT

STATESVILLE 704-878-5305 MOORESVILLE 704-664-5281

12"

662-8486

## IMPROVEMENT PERMIT / ~~CERTIFICATE OF COMPLETION~~ / OPERATION PERMIT / EXISTING SYSTEM INSPECTION

PROPERTY DESCRIPTION NO. 069467 DATE 10/23/97 TAX MAP NO. 462 5577217 4625 478356 Watershed: ☒ ~~Yes~~ ☐ No

OWNER OR CONTRACTOR M/I HOMES PHONE: Business 663-6405 TJACOBS Home

ADDRESS BRAWLEY SCHOOL RD - TR BAY HARBOUR - TL LAKE MIST - JR SILVER EAGLE - 3RD ON LT

LOCATION

SUBDIVISION HARBOUR BLOCK / SECTION 4 LOT 26 LOT AREA SITE CLASS. RS DESIGN FLOW 480 GPD L.T.A.R. .36 AC/FT ±

Septic Tank: 1000 Gallons; STB 794 Date 2/16/98

Pump Tank: 1000 Gallons; PT 27 Date 2

Pump Make: HYDROMATIC Model SHEF 50A1 Serial No. 5/9/98

Nitrification Field: No Fields 1 Square Feet 1200 Linear Feet 400

No Lines 3 @ 133' Trench Width 36" Max Trench Bottom Depth 36" Gravel Depth N/A

☒ New System ☐ Repair System Type: I, II, (III), IV, V, VI

System Description: PUMP CHAMBERED OR HOS

Repair System Description: PUMP PANEL

Maintenance Agreement Required: ☐ Yes ☒ No

☒ House/Mod. Home No. Bedrooms 4

☐ Mobile Home No. Bathrooms 4

☐ Business No. Employees

☐ Other


☐ Slab ☐ Crawl Space ☒ Basement w/plumbing ☐ Basement wo/plumbing

Water Supply: ☐ Individual ☒ Community ☐ Public


Comments:

Comments: 1000 GAL TANK = 1800 GAL TOTAL

**INITIAL SITE SKETCH** 1" = 50'

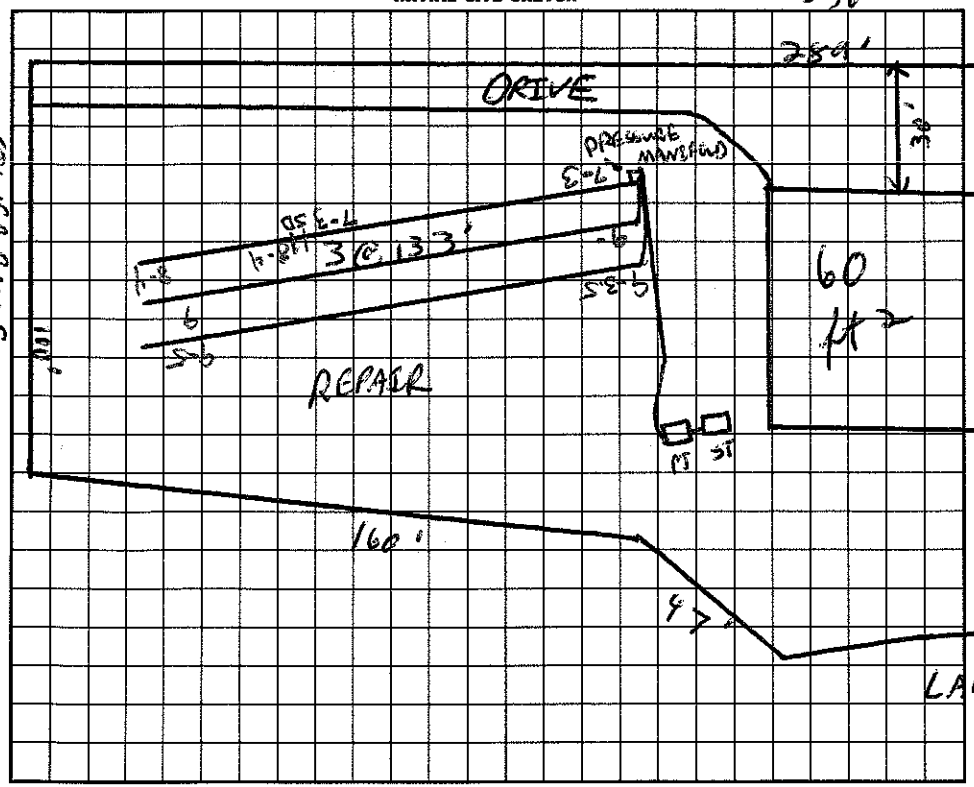


**AS BUILT SKETCH**

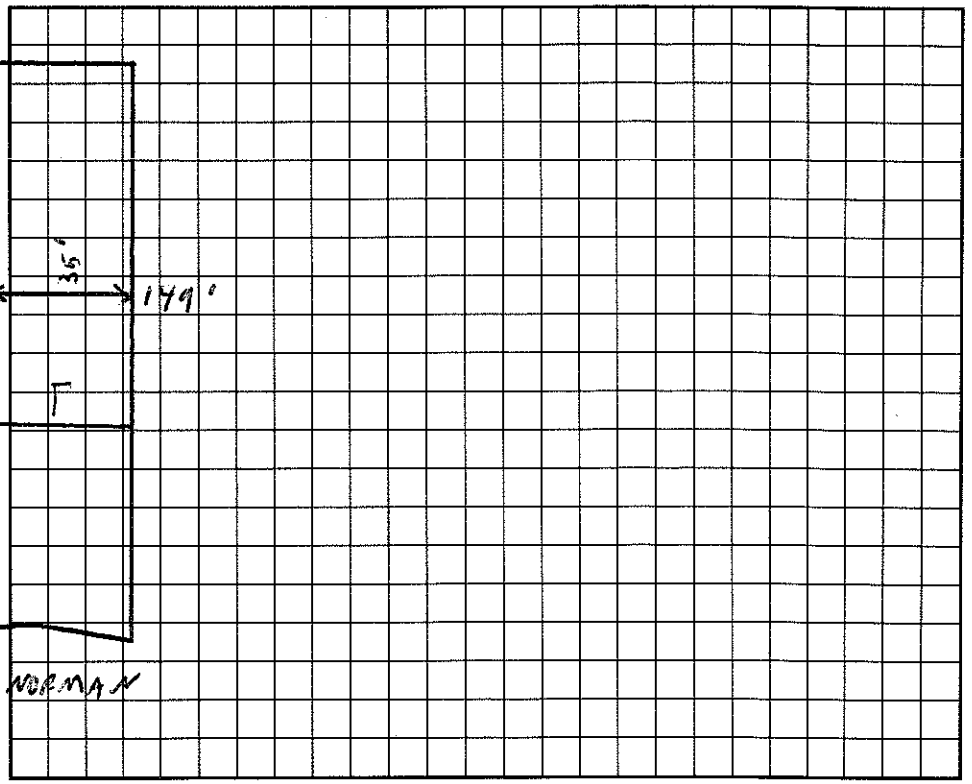


I understand that this permit can be suspended or revoked if any false information is supplied toward securing the permit/any unauthorized changes are made to the site/any unauthorized changes are made in the installation of the system. Improvement Permit is valid for 60 months from date of issuance.

Signed: Tony C. Jacobs 10-24-97 Installed by: MacLeod Const.

Improvement Permit by: C. Rudy Freeman RS date 10/23/97 Certificate of Completion by: date

AUTHORIZATION TO CONSTRUCT ~~Existing System Inspection by~~: C. Rudy Freeman RS date 10/23/97 Operation Permit by: C. Rudy Freeman RS date 6/9/98

HEALTH DEPT. COPY: WHITE INSPECTION COPY (FINAL): GREEN OWNER COPY (FINAL): YELLOW INSPECTION COPY (INITIAL): PINK OWNER COPY (INITIAL): GOLD