# IREDELL COUNTY HEALTH DEPARTMENT

AUTHORIZATION TO CONSTRUCT

STATESVILLE 704-878-5305 MOORESVILLE 704-664-5281

## IMPROVEMENT PERMIT / ~~CERTIFICATE OF COMPLETION~~ / OPERATION PERMIT / EXISTING SYSTEM INSPECTION

PROPERTY DESCRIPTION NO. 069464 DATE 10/23/97 TAX MAP NO. ~~4635-77-17-47~~ Watershed: ☑ Yes ☐

OWNER OR CONTRACTOR M/I HOMES PHONE: Business 663-6905 T JACOBS ~~Home~~ 4625-47-9365

ADDRESS 1043 E MOREHEAD ST CHARLOTTE NC 28273

LOCATION BRAWLEY SCHOOL - TR BAY HARBOUR - TL LAKEMIST - TR SILVER EAGLE LN 2nd ON LT

SUBDIVISION HARBOUR BLOCK / SECTION 4 LOT 25 LOT AREA - SITE CLASS. RS DESIGN FLOW 450 GPD L.T.A.R. .36 GPD/FT²

Septic Tank: 1000 Gallons; STB 794 Date 1/2/98

Pump Tank: ____ Gallons; PT ____ Date ____

Pump Make: ____ Model ____ Serial No. ____

Nitrification Field: No Fields 1 Square Feet 1611 Linear Feet 539

No Lines 7@77' Trench Width 36" Max Trench Bottom Depth 36" Gravel Depth 12"

☑ New System ☐ Repair System Type: I, II, III, IV, V, VI

System Description: GRAVITY CONVENTIONAL

Repair System Description: GRAV. CHAMBERED OR HDS

Maintenance Agreement Required: ☐ Yes ☑ No

☑ House/Mod. Home No. Bedrooms 4

☐ Mobile Home No. Bathrooms 4

☐ Business No. Employees ____

☐ Other ____

☐ Slab ☑ Crawl Space ☐ Basement w/plumbing ☐ Basement wo/plumbing


Water Supply: ☐ Individual ☑ Community ☐ Public

Comments:


Comments:

### INITIAL SITE SKETCH

1" = 50'

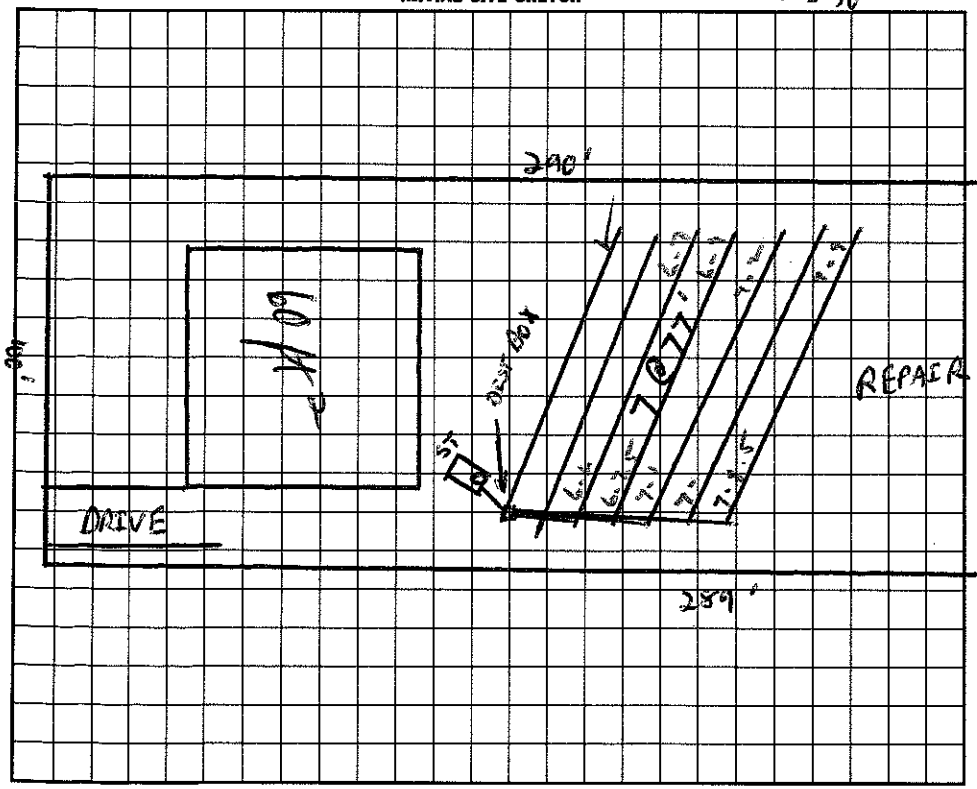


### AS BUILT SKETCH

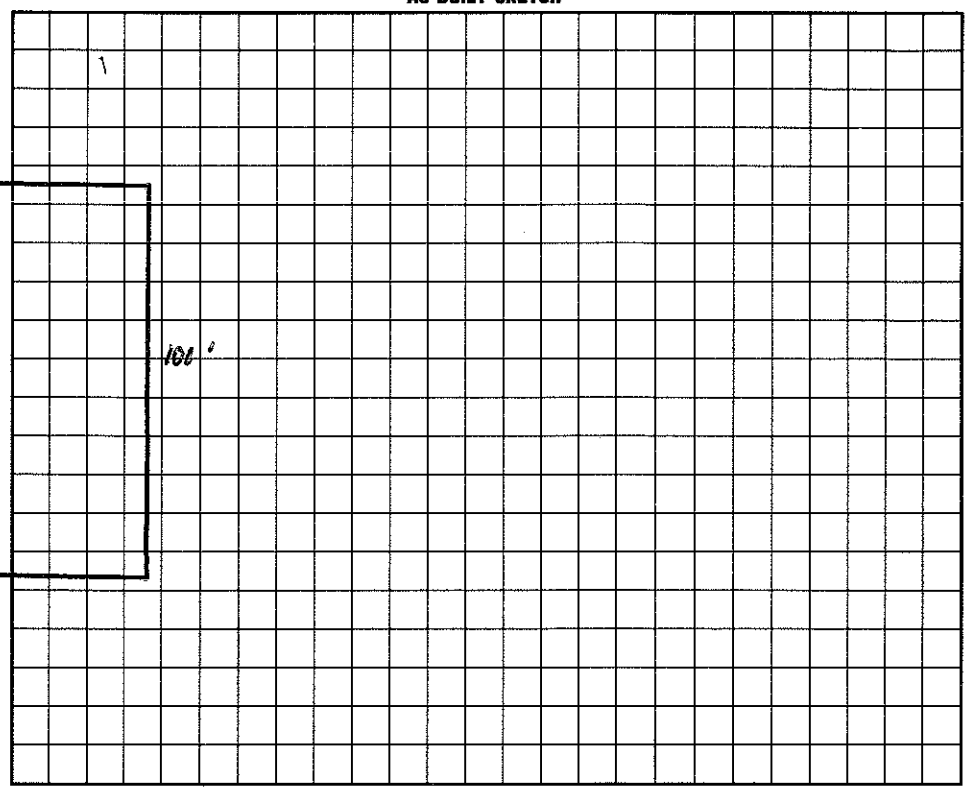


I understand that this permit can be suspended or revoked if any false information is supplied toward securing the permit/any unauthorized changes are made to the site/any unauthorized changes are made in the installation of the system. Improvement Permit is valid for 60 months from date of issuance.

Signed: Tony Jacobs 10-24-97 Installed by: Morehead Const. Co.

Improvement Permit by: C. Brady Freeman LS date 10/23/97 Certificate of Completion by: Wesley Sparks RS. date 4/16/98

AUTHORIZATION TO CONSTRUCT Existing System Inspection By: C. Brady Freeman LS date 10/23/97 Operation Permit by: Wesley Sparks RS. date 4/16/98

HEALTH DEPT. COPY: WHITE INSPECTION COPY (FINAL): GREEN OWNER COPY (FINAL): YELLOW INSPECTION COPY (INITIAL): PINK OWNER COPY (INITIAL): GOLD