IREDELL COUNTY HEALTH DEPARTMENT

STATESVILLE 704-878-5305 MOORESVILLE 704-664-5281

IMPROVEMENT PERMIT / AUTHORIZATION TO CONSTRUCT / OPERATION PERMIT / EXISTING SYSTEM INSPECTION

PERMIT# 26257 PIN# 4625479851 DATE 5/15/98

OWNER OR CONTRACTOR MI HOMES PHONE: Business Home

ADDRESS 1043 E MOREHEAD ST CHARLOTTE NC

LOCATION BRAWLEY SCHOOL - TR BAY HARBOUR - TL LAKE NEST - TR HUNTER SPRING

SUBDIVISION HARBOUR BLOCK / SECTION II LOT 32 LOT AREA SITE CLASS. RS DESIGN FLOW 600 GPD L.T.A.R. .25

Septic Tank: 1500 Gallons; STB 797 Date 1/11/97

Pump Tank: 1500 Gallons; PT 797 Date 1/11/97

Pump Make: HYDROMATIC Model SHEFSOAI Serial No. 11-97

Nitrification Field: No Fields 1 Square Feet 800 Linear Feet 400

No Lines 7 Trench Width 24" Max Trench Bottom Depth 36" Gravel Depth N/A

☑ New System ☐ Repair System Type: I, II, III (IV) V, VI

System Description: PUMP PANEL

Repair System Description: PUMP PANEL OFFSIDE

Maintenance Agreement Required: ☑ Yes ☐ No

☑ House/Mod. Home No. Bedrooms 5

☐ Mobile Home No. Bathrooms 5

☐ Business No. Employees

☐ Other

☐ Slab ☑ Crawl Space ☐ Basement w/plumbing ☐ Basement wo/plumbing


Water Supply: ☐ Individual ☐ Public ☑ Community

Comments:/Conditions:

1"=30'


Comments:/Conditions:

INITIAL SITE SKETCH

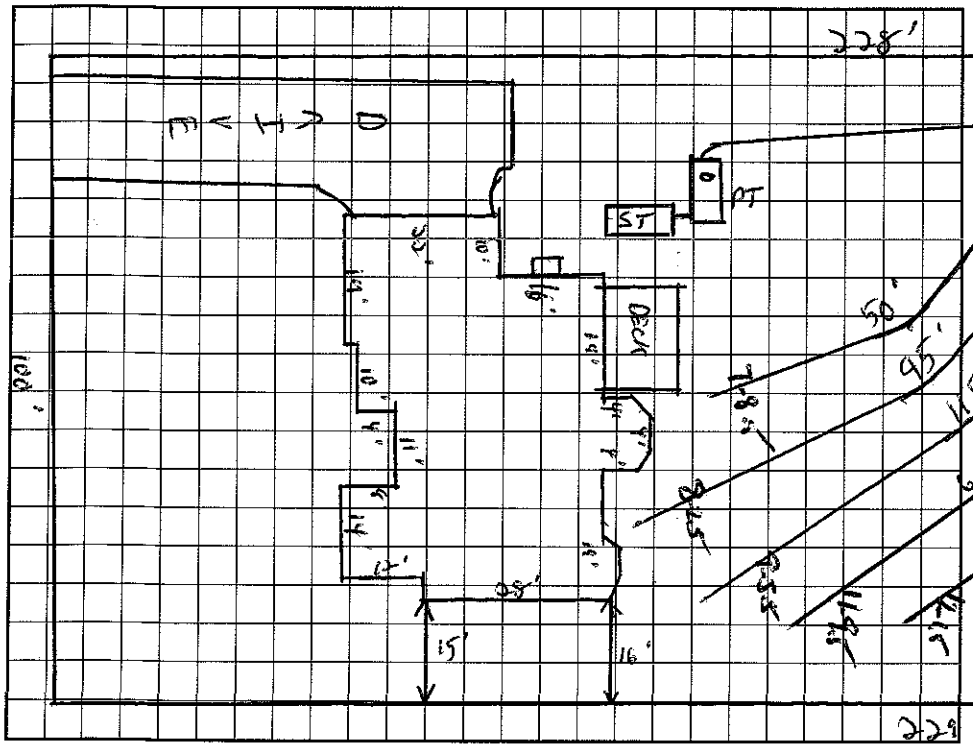

CENTRAL GATE VALVE BOX

AS BUILT SKETCH

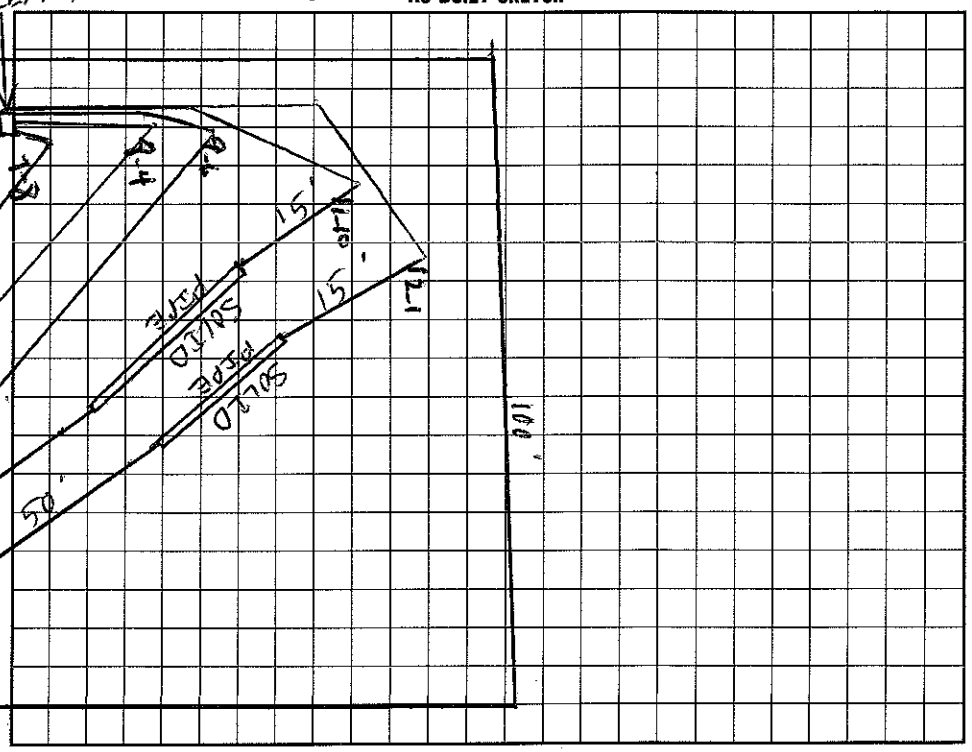

I understand that this permit can be suspended or revoked if any false information is supplied toward securing the permit/any unauthorized changes are made to the site/any unauthorized changes are made in the installation of the system. Improvement Permit with plat valid without expiration. Improvement Permit with site plan valid for sixty months. Authorization to Construct is valid for a period equal to that of Improvement Permit – not to exceed sixty months.

Signed: Tony C Jones date 5-18-98 Installed by: Mackey Const.

Improvement Permit by: RS date 5/18/98 Operation Permit by: Wesley Sparks RS. date 5/28/98

Authorization to Construct by: RS date 5/18/98 Existing System Inspection by: Wesley Sparks RS. date 5-28-98

HEALTH DEPT. COPY: WHITE INSPECTION COPY (FINAL): GREEN OWNER COPY (FINAL): YELLOW INSPECTION COPY (INITIAL): PINK OWNER COPY (INITIAL): GOLD