IREDELL COUNTY HEALTH DEPARTMENT

STATESVILLE 704-878-5305 MOORESVILLE 704-664-5281

IMPROVEMENT PERMIT / CERTIFICATE OF COMPLETION / OPERATION PERMIT / EXISTING SYSTEM INSPECTIO

PROPERTY DESCRIPTION NO. 19001 DATE Jan 6, '95 TAX MAP NO. part of 2CA3 4625 484776 Watershed: ☑ Yes ☐ N WS IV

OWNER OR CONTRACTOR Crescent Resources Inc PHONE: Business Home

ADDRESS PO Box 10003 Charlotte

LOCATION 1105 TR Bay Harbour Rd. TL Lake Mist Dr. TR Sunrise Circle

SUBDIVISION The Harbour BLOCK / SECTION MAP D LOT 36, 36A LOT AREA offsite sewers SITE CLASS Spa 1456 DESIGN FLOW 480 gpd L.T.A.R. .3 (easement)

Septic Tank: 1000 Gallons; STB 794 Dellinger Date 4-26-95

Pump Tank: 1000 Gallons; PT 27 Dellinger Date 4-24-95

Pump Make: Model Serial No.

Nitrification Field: No Fields 1 Square Feet Linear Feet 267

No Lines 4-6 Trench Width 24" Max Trench Bottom Depth 28" Gravel Depth NA

☑ New System ☐ Repair System Type: I, II, III, IV, V, VI

System Description: CAPPBDS LP PPBDS

Repair System Description:

Maintenance Agreement Required: ☑ Yes ☐ No

☑ House/Mod. Home No. Bedrooms 4

☐ Mobile Home No. Bathrooms 4

☐ Business No. Employees

☐ Other

☐ Slab ☑ Crawl Space ☐ Basement w/plumbing ☐ Basement wo/plumbing


Water Supply: ☐ Individual ☑ Community ☐ Public

Comments: Laterals to follow contour.


Comments: DEVELOPER PERMIT EXPIRED

4/7/95 OK to use 400' Infiltrator @ 100' each for initial system as staked by Tony Carlton

INITIAL SITE SKETCH

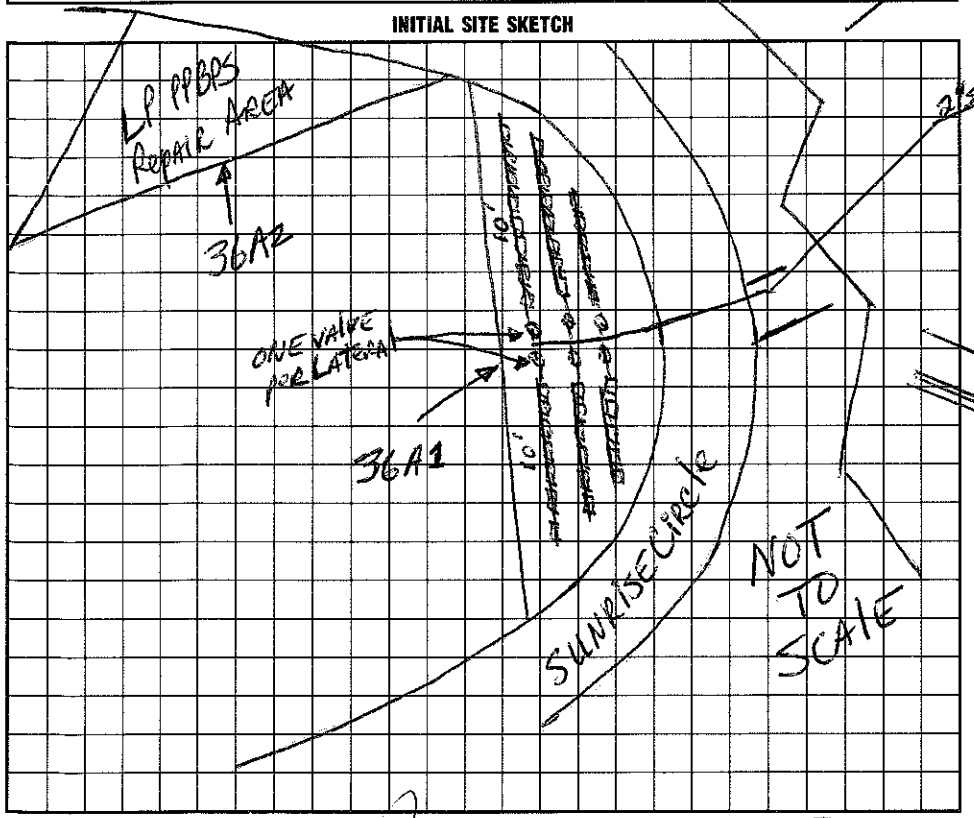

AS BUILT SKETCH

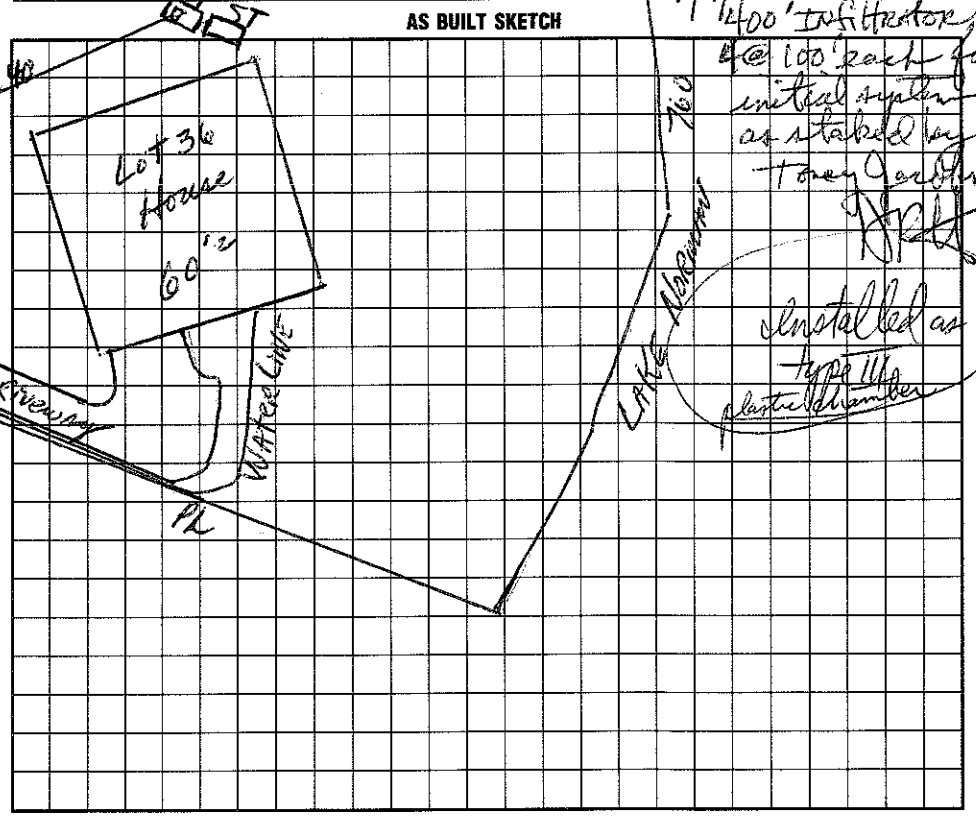

I understand that this permit can be suspended or revoked if any false information is supplied toward securing the permit/any unauthorized changes are made to the site/any unauthorized changes are made in the installation of the system. Improvement Permit is valid for 60 months from date of issuance.

Signed:

Improvement Permit by: Agent date 1-5-95

Existing System Inspection by: date

Installed by: Ken Painter / Iron Horse Grading

Certificate of Completion by: Wesley Sparks R.S. date 8/17/95

Operation Permit by: Wesley Sparks R.S. date 8/17/95

HEALTH DEPT. COPY: WHITE INSPECTION COPY (FINAL): GREEN OWNER COPY (FINAL): YELLOW INSPECTION COPY (INITIAL): PINK OWNER COPY (INITIAL): GOLD