IREDELL COUNTY HEALTH DEPARTMENT
ENVIRONMENTAL HEALTH DIVISION
Application For Improvement Permit

ALL items on this application form must be completed before Health Department can begin work. One application must be completed by the property owner or agent for each (proposed) site.

PERSONAL INFORMATION:

Applicant	Phone #	Mailing Address	City	State	Zip Code
Crescent Resources Inc	663-6905	P.O. Box 10003	Char	NC	28201
Current Property Owner		Mailing Address	City	State	Zip Code
"		"	"	"	"

PROPERTY INFORMATION:

(Proposed) Subdivision Name	(Proposed) Lot #	(Proposed) Block/Section #	State Road #
The Harbour	30	phase 1 map D	

(Proposed) Water Supply: Public, Private Well

Preliminary Plat Approval Date (DEVELOPERS ONLY): 4-19-94

Tax Map #: 2C-A-3

Specific Directions to Property: SR 1106 Rt. Bay Harbour

TYPE OF FACILITY: (use check (X) or number as appropriate)

House ✓ Mobile Home ____ Commercial ____ No. Bedrooms 4 No. Baths 4

No. Persons or Employees (commercial only) ____ Basement ~~N~~ Basement with Plumbing ~~N~~

Crawl Space ✓ Concrete Slab ____ Garbage Disposal No Jaccuzi or spa No

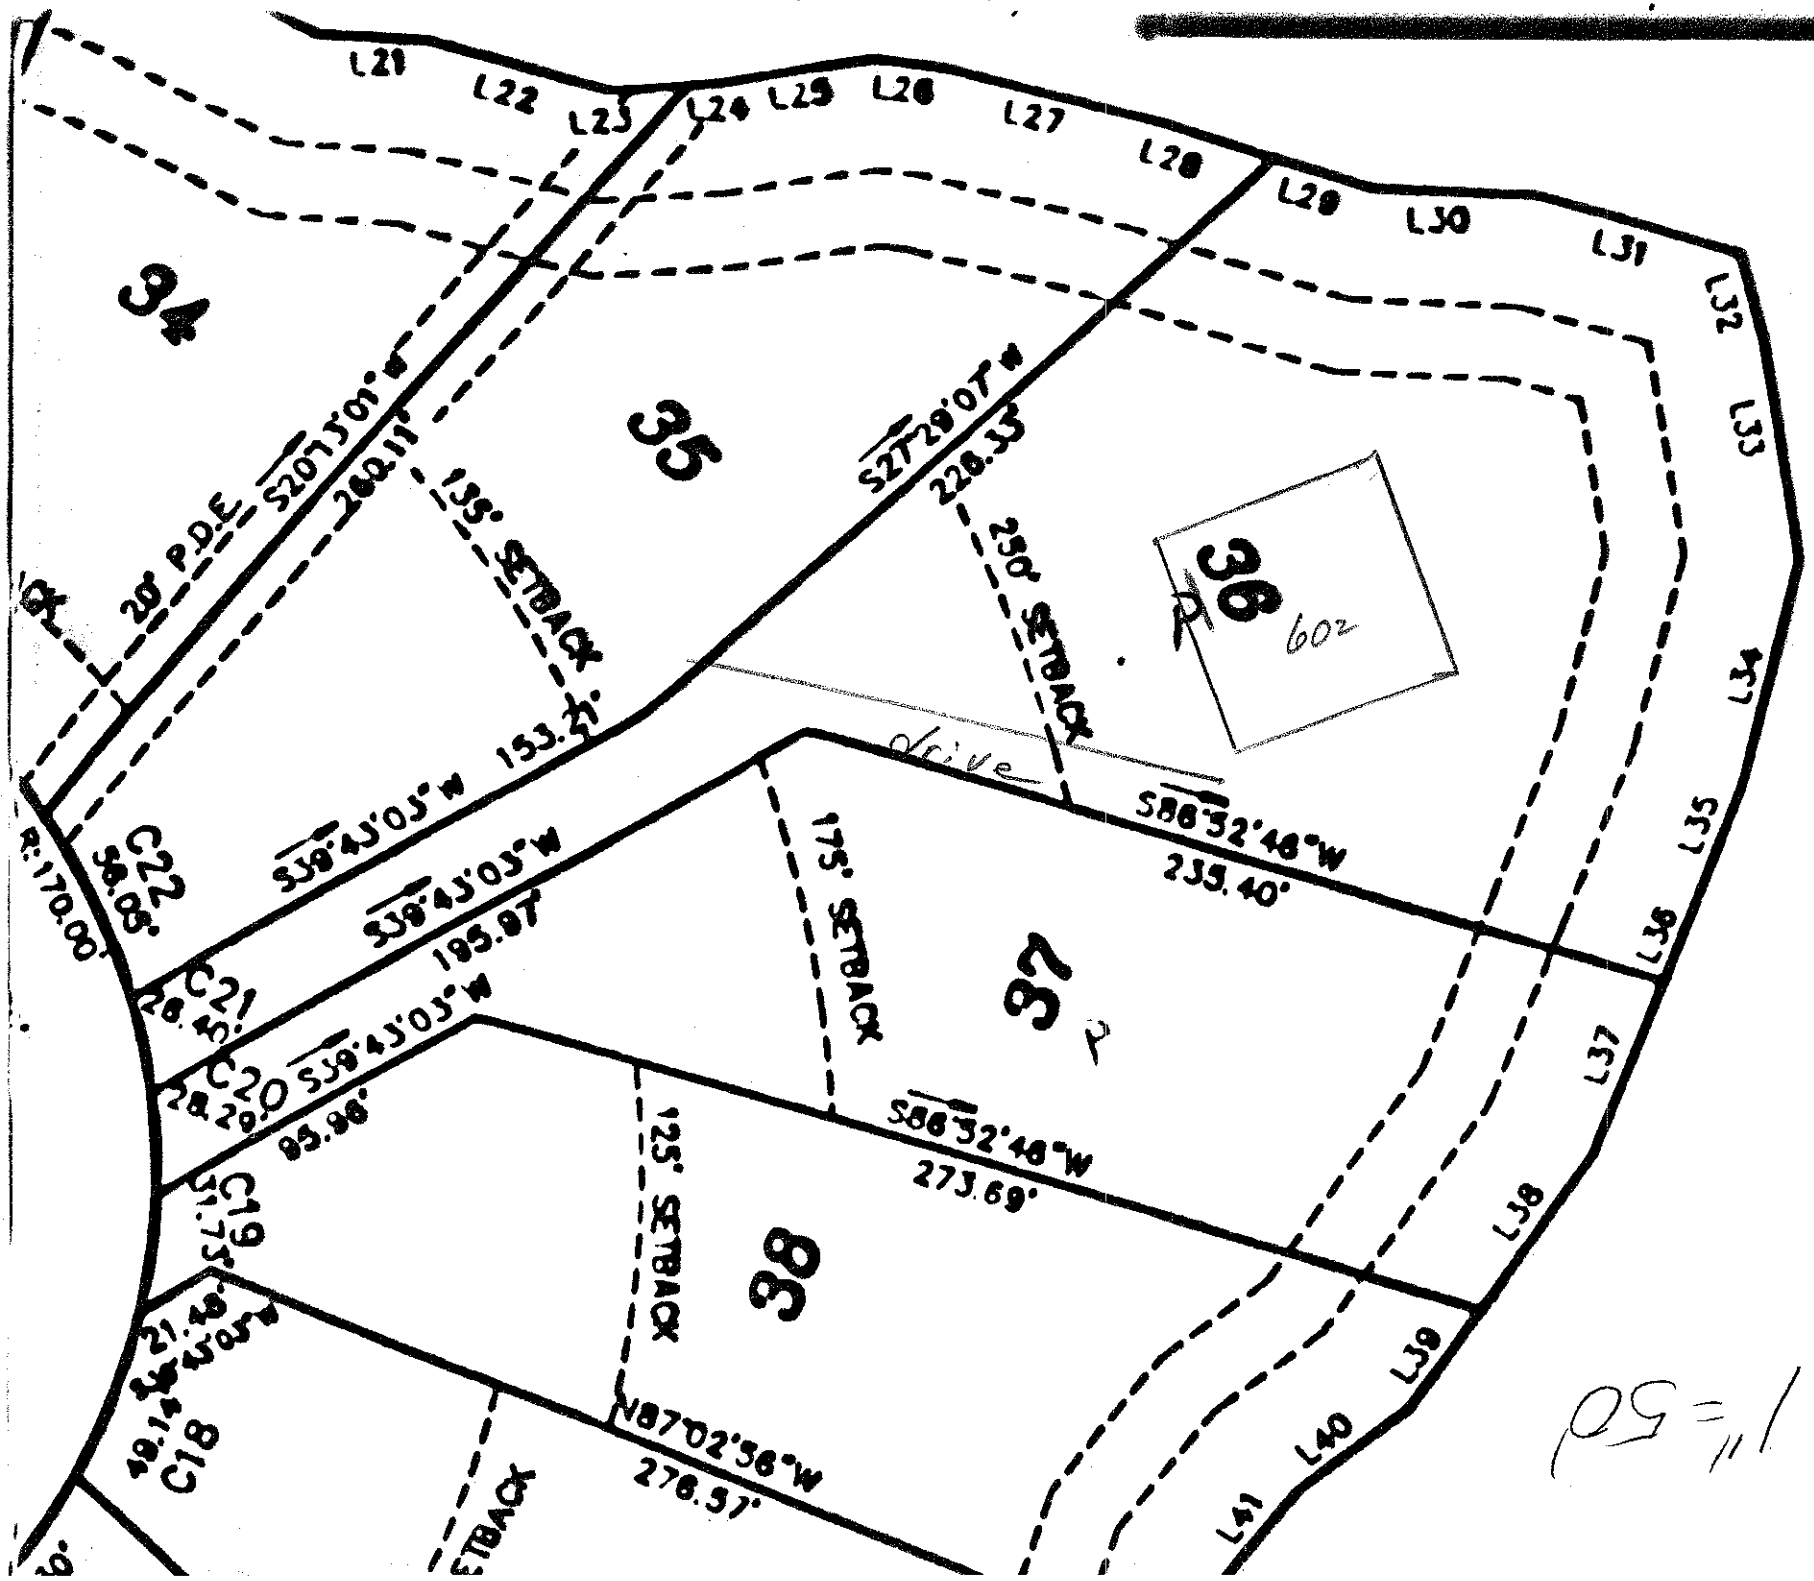
A.L. per T.I. 7/26/94

COVENANT AND SIGNATURE:

I hereby make application to the Iredell County Health Department for a soils/site evaluation of the property described above. This evaluation is to be conducted for the sole purpose of obtaining a septic system Improvement Permit. I hereby authorize Iredell County Health Department representatives to go onto the above property for purposes of conducting this evaluation. I understand that, by state law, any Improvement Permit issued on the above property may be voided if substantial changes are made to the designated sewage system site. The issuance of an Improvement Permit by the Iredell County Health Department does not relieve me from compliance with all other relevant state/local laws or regulations. As owner or authorized agent, I covenant that the contents of this application are true and represent the maximum facilities intended to be placed on this property to my knowledge to date.

I understand that any Improvement Permit issued on the above property is valid for five (5) years from the issuance date and is subject to revocation if the above described site plans or intended use changes.

6-15-94 DATE Tonya C Jacobs, CPSS SIGNATURE OF OWNER/AUTHORIZED AGENT


L21
L22
L23
L24
L25
L26
L27
L28
L29
L30
L31
L32
L33
L34
L35
L36
L37
L38
L39
L40
L41
34
35
36
37
38
602
20' P.D.E.
S20°13'01"E
260.11'
155' SETBACK
S27°29'07"E
228.33'
250' SETBACK
drive
S86°32'48"W
239.40'
175' SETBACK
S38°43'05"W
193.97'
133.27'
R:170.00'
C22
56.85'
C21
56.85'
C20
85.98'
C19
51.75'
C18
49.14'
S38°43'05"W
125' SETBACK
S86°32'48"W
273.69'
N87°02'36"W
276.57'
1" = 50'
CERTIFY
SURVEY
ACKNOW
WITNESS
DAY OF
MY COM
DEPAR
DI
CONS
APPROVED_
DATE_____
AS OF THE
ON THIS PL
THE IREDELL
THERE IS N
ISSUED.