4625 48 4888

IREDELL COUNTY HEALTH DEPARTMENT

→ AUTHORIZATION TO CONSTRUCT

50

STATESVILLE 704-878-5305 MOORESVILLE 704-664-5281

IMPROVEMENT PERMIT / ~~CERTIFICATE OF COMPLETION~~ / OPERATION PERMIT / EXISTING SYSTEM INSPECTION

PROPERTY DESCRIPTION NO. 21684 DATE 12/19/96 TAX MAP NO. pt of 2CA3 Watershed: ☐ Yes ☐ No

OWNER OR CONTRACTOR M/I HOMES PHONE: Business 663-6905 Home

ADDRESS ~~BRAWLEY~~

LOCATION BRAWLEY SCHOOL RD. TR BAY HARBOUR. TL LAKE MIST RD. TR SAND KNOLL LANE.

SUBDIVISION HARBOUR BLOCK / SECTION 1 LOT 37,37A LOT AREA SITE CLASS. PS DESIGN FLOW 480 GPD L.T.A.R. .36 GPD/FT²

Septic Tank: 1000 Gallons; STB Date

Pump Tank: 1000 Gallons; PT Date

Pump Make: HYDROMATIC Model SKHD ISOM3 Serial No.

Nitrification Field: No Fields 1 Square Feet 840 Linear Feet 240

No Lines 7 @ 40' Trench Width 24" Max Trench Bottom Depth 36" Gravel Depth N/A

☑ New System ☐ Repair System Type: I, II, III, (IV) V, VI

System Description: PUMP PANEL - OFF SITE

Repair System Description: SAME - ON SITE

Maintenance Agreement Required: ☑ Yes ☐ No

☑ House/Mod. Home No. Bedrooms 4

☐ Mobile Home No. Bathrooms 4

☐ Business No. Employees

☐ Other


☐ Slab ☑ Crawl Space ☐ Basement w/plumbing ☐ Basement wo/plumbing

Water Supply: ☐ Individual ☑ Community ☐ Public


Comments: * GULLY TO BE FILLED PROPERLY BEFORE SYSTEM CAN BE COMPLETE.
*SUPPLY LINE SHALL FOLLOW DRIVE - NOT TO CUT INTO REPAIR AREA

Comments:

INITIAL SITE SKETCH

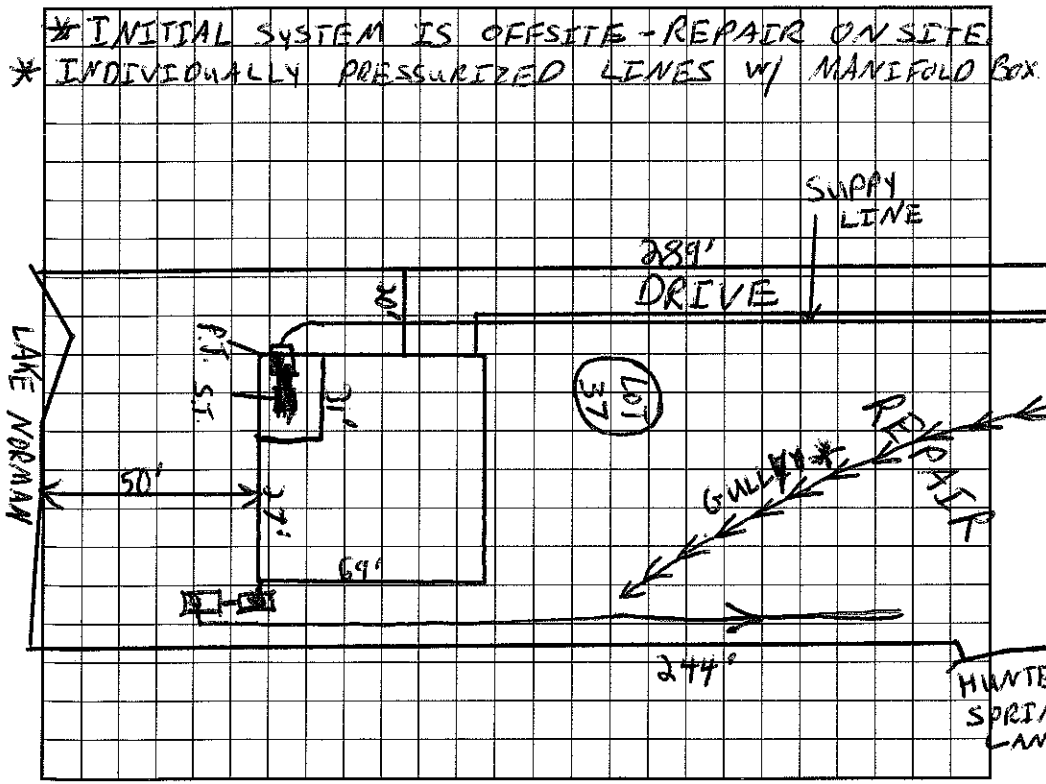

AS BUILT SKETCH

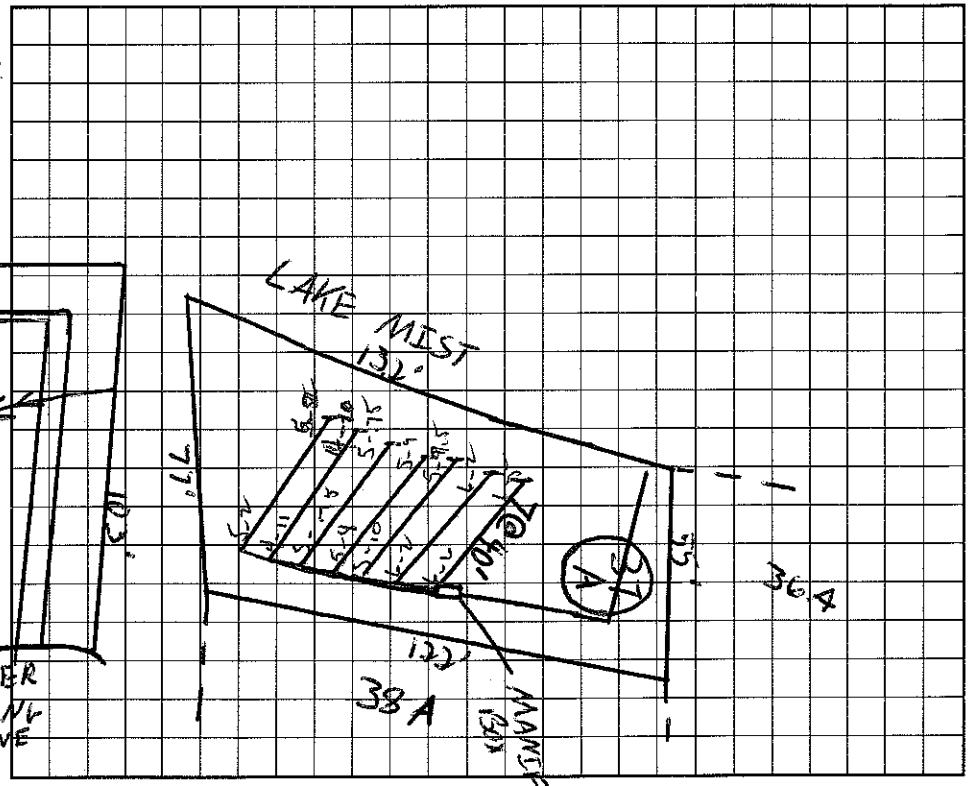

I understand that this permit can be suspended or revoked if any false information is supplied toward securing the permit/any unauthorized changes are made to the site/any unauthorized changes are made in the installation of the system.

Signed: Tammy C. Smith, CPS (Agent)

Improvement Permit by: C. Ray Teem EHSI date 12/19/96

~~Existing System Inspection by:~~ AUTHORIZATION TO CONSTRUCT C. Ray Teem EHSI date 12/19/96

Installed by: Machado Const.

Certificate of Completion by: Wesley Sparks RS. date 5/8/97

Operation Permit by: Wesley Sparks RS. date 5/8/97

HEALTH DEPT. COPY: WHITE INSPECTION COPY (FINAL): GREEN OWNER COPY (FINAL): YELLOW INSPECTION COPY (INITIAL): PINK OWNER COPY (INITIAL): GOLD