4625 48 6769

IREDELL COUNTY HEALTH DEPARTMENT

STATESVILLE 704-878-5305 MOORESVILLE 704-664-5281

IMPROVEMENT PERMIT / CERTIFICATE OF COMPLETION / OPERATION PERMIT / EXISTING SYSTEM INSPE

PROPERTY DESCRIPTION NO. 19009 DATE Jan. 13, 195 TAX MAP NO. part of 2CA3 Watershed: ☑ ☐

OWNER OR CONTRACTOR Crestent Resources Inc PHONE: Business Home

ADDRESS PO Box 1003, Charlotte

LOCATION 4160 TR Bay Harbour Dr. TL Lake Mist Dr. TR Sunrise Circle 16th lot on Right

SUBDIVISION The Harbour BLOCK / SECTION Map D LOT 35 LOT AREA 25,000ft²+ SITE CLASS PB per 1956 DESIGN FLOW 480gpd L.T.A.R. .3

Septic Tank: 1000 Gallons; STB Date

Pump Tank: 1000 Gallons; PT Date

Pump Make: Model Serial No.

Nitrification Field: No Fields 1 Square Feet Linear Feet 267

No Lines 4 Trench Width 24" Max Trench Bottom Depth 30" Gravel Depth NA

☑ New System ☐ Repair System Type: I, II, III, (IV), V, VI

System Description: LP PBPS

Repair System Description: LP PPBPS

Maintenance Agreement Required: ☑ Yes ☐ No

☑ House/Mod. Home No. Bedrooms 4

☐ Mobile Home No. Bathrooms 4

☐ Business No. Employees

☐ Other

☐ Slab ☑ Crawl Space ☐ Basement w/plumbing ☐ Basement wo/plumbing


Water Supply: ☐ Individual ☑ Community ☐ Public

Comments: This permit replaces permit issued Oct 19, '94
Laterals to follow contour.


Comments: READY TO ISSUE Shows pool & swimming pool on site today, as shown on site plan. Match location as put on as built. Shown on Initial Location

1"=40'

INITIAL SITE SKETCH

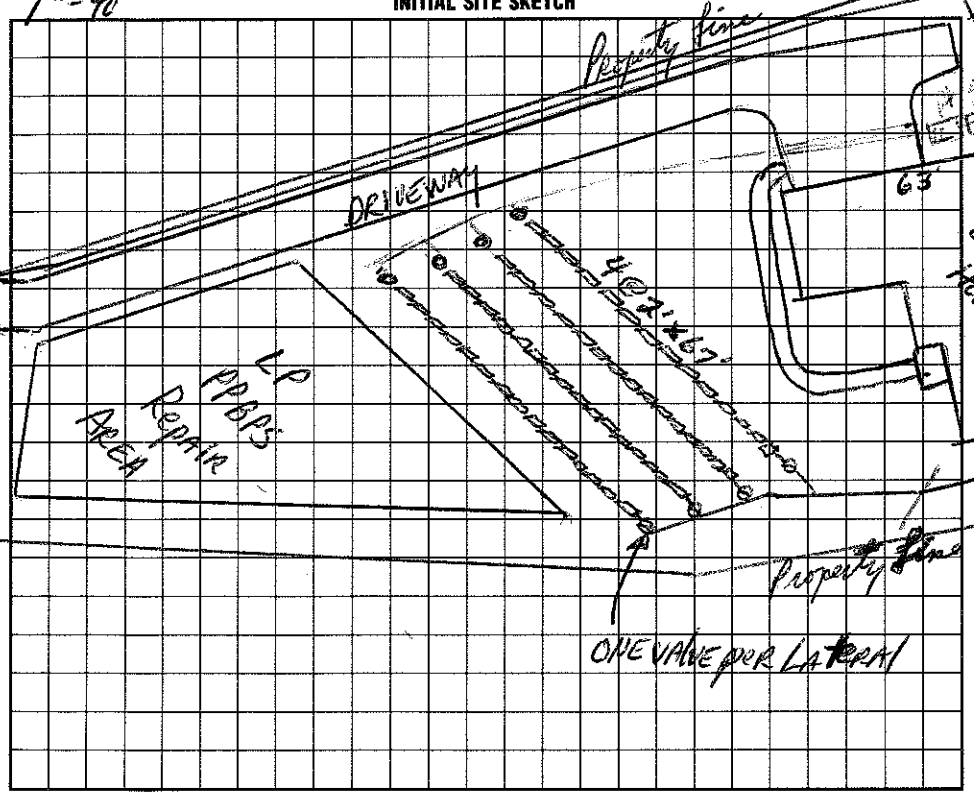

AS BUILT SKETCH

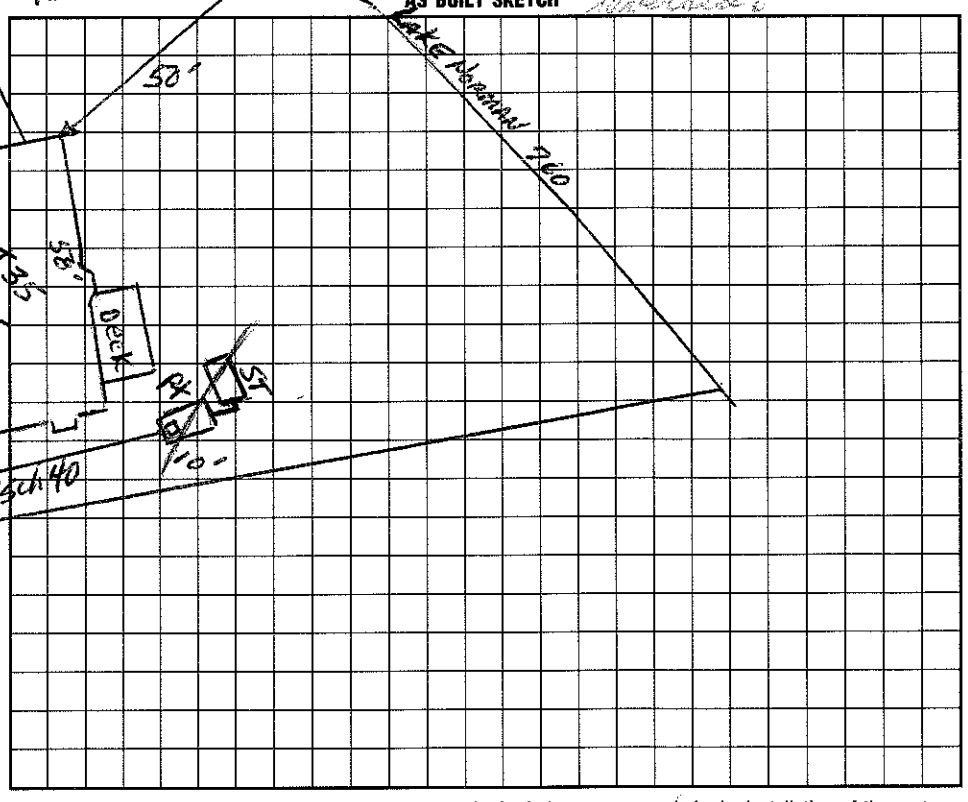

I understand that this permit can be suspended or revoked if any false information is supplied toward securing the permit/any unauthorized changes are made to the site/any unauthorized changes are made in the installation of the system. Improvement Permit is valid for 60 months from date of issuance.

Signed: Tony Gaskill, EPSS(PI) Installed by: Mac Beal

Improvement Permit by: D R Hinson, RS date 1-13-95

Existing System Inspection by: date

Certificate of Completion by date

Operation Permit by: D R Hinson, RS date 8-8-95

HEALTH DEPT. COPY: WHITE INSPECTION COPY (FINAL): GREEN OWNER COPY (FINAL): YELLOW INSPECTION COPY (INITIAL): PINK OWNER COPY (INITIAL): GOLD