IREDELL COUNTY HEALTH DEPARTMENT

STATESVILLE 704-878-5305 MOORESVILLE 704-664-5281

IMPROVEMENT PERMIT / CERTIFICATE OF COMPLETION / OPERATION PERMIT / EXISTING SYSTEM INSPECTION

PROPERTY DESCRIPTION NO. 18999 DATE Oct 19, 194 TAX MAP NO. part of 2CA3 Watershed: ☑ Yes ☐ No

OWNER OR CONTRACTOR Crescent Resources, Inc / MI Homes PHONE: Business Home CN

ADDRESS PO Box 1003, Charlotte 1716 Summit Circle, Mooresville NC 28115

LOCATION Brawley Sch. Rd TR Brighton Dr. TL LAKE Mistike. TR Sunshine Circle 1st lot on Rt.

SUBDIVISION The Harbour BLOCK / SECTION Map D LOT 34 LOT AREA 25,000 ft² SITE CLASS. PS per 1956 DESIGN FLOW 480 gpd L.T.A.R. .25

Septic Tank: 1000 Gallons; STB 794 Date 3/14/95

Pump Tank: 1000 Gallons; PT 27 Date 9/9/95

Pump Make: Gould's Model WE05111H1 Serial No. ~~SIC1195~~

Nitrification Field: No Fields 1 Square Feet Linear Feet 320

No Lines 4 Trench Width 24" Max Trench Bottom Depth Gravel Depth

☑ New System ☐ Repair System Type: I, II, III, (IV) V, VI

System Description: LPPPBPS

Repair System Description: CPPPBPS

Maintenance Agreement Required: ☑ Yes ☐ No

☑ House/Mod. Home No. Bedrooms 4

☐ Mobile Home No. Bathrooms 4

☐ Business No. Employees

☐ Other

☐ Slab ☑ Crawl Space ☑ Basement w/plumbing ☐ Basement wo/plumbing

Water Supply: ☐ Individual ☑ Community ☐ Public

Comments: Laterals to follow contour. Water line installation must not cross septic system area. Pump pipes to be determined at time of system installation

A9508 357


Comments: Plan submitted substantially the same as on this permit except it has been reversed. Driveway to now be on left side boundary. Septic tank and PT to be located as shown on plot plan

DEVELOPER PERMIT

READY TO ISSUE 4/4/95

175 = 8.75 - 9

INITIAL SITE SKETCH

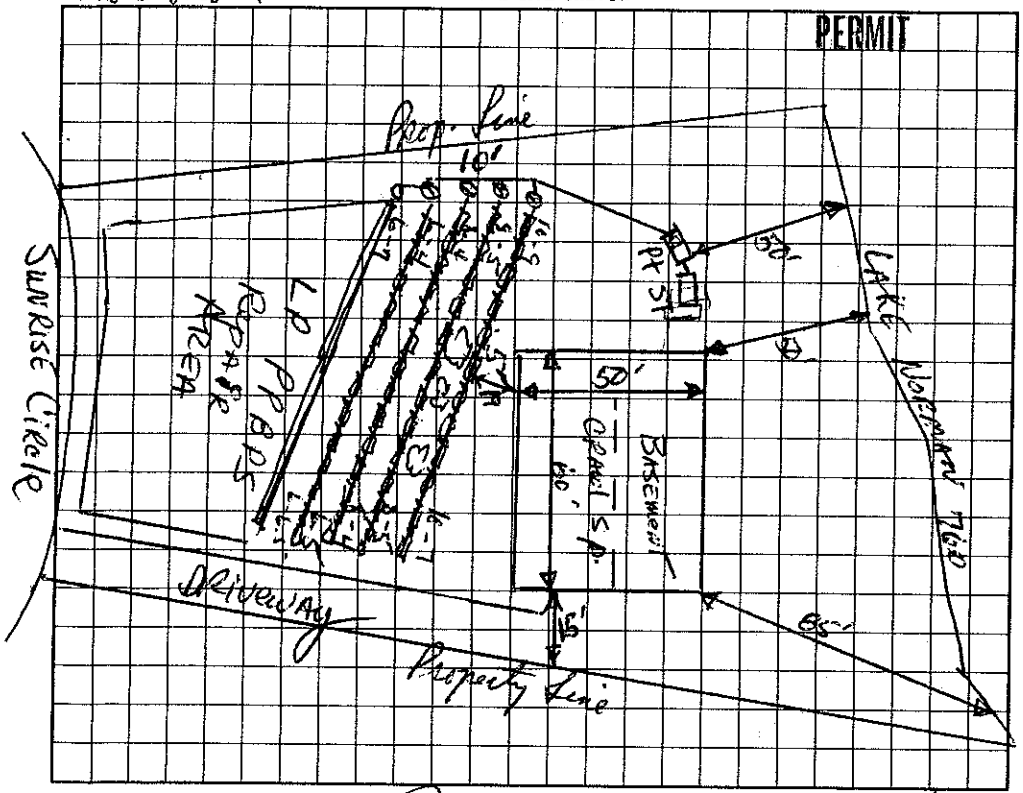

AS BUILT SKETCH

9/29/95 - Drain Lines inspected and approved 5@ 67' ea' installed

10/2/95 Need 2 Rec. Markers, + Manhole Risers

I understand that this permit can be suspended or revoked if any false information is supplied toward securing the permit/any unauthorized changes are made to the site/any unauthorized changes are made in the installation of the system. Improvement Permit is valid for 60 months from date of issuance.

Signed: Tom [illegible] RS 10/24/94

Improvement Permit by: [illegible] RS date 10/19/94

Existing System Inspection by: Construct. Wesley Sparks date 10/24/95

Installed by: Maryland Const. Co.

Certificate of Completion by: date

Operation Permit by: Wesley Sparks R.S. date 4/24/96

INSPECTION COPY (FINAL): GREEN OWNER COPY (FINAL): YELLOW INSPECTION COPY (INITIAL): PINK OWNER COPY (INITIAL): GOLD