878-3171

IREDELL COUNTY HEALTH DEPARTMENT / Wastewater Application to Construct

STATESVILLE 704-878-5305 MOORESVILLE 704-664-5281

IMPROVEMENT PERMIT / ~~CERTIFICATE OF COMPLETION~~ / OPERATION PERMIT / EXISTING SYSTEM INSPECTION

PROPERTY DESCRIPTION NO. 21686 DATE 10/15/96 TAX MAP NO. 2C A 3 Pt of. Watershed: [X] Yes [ ] No

OWNER OR CONTRACTOR MI Homes PHONE: Business 4625-48-9047 Home 704-373-3012

ADDRESS 400 S Tryon St. #1300 Charlotte, NC. 28202

LOCATION Bigwalley Sch Rd. TR Bay Harbor Tr Lake Mist Rd. TR Sandknoll Ln. Left on ② before cul de sac.

SUBDIVISION Harbour BLOCK / SECTION II LOT 39 LOT AREA 24149 SITE CLASS. PS DESIGN FLOW 480 L.T.A.R. .3

Septic Tank: 1000 Gallons; STB 794 Date 1/14/97
Pump Tank: ____ Gallons; PT ____ Date ____
Pump Make: ____ Model ____ Serial No. ____
Nitrification Field: No. Fields 1 Square Feet 1200 Linear Feet 400+
No Lines 6 Trench Width 36" Max Trench Bottom Depth 36" Gravel Depth SAND

[X] New System [ ] Repair System Type: I, II, III, IV, V, VI
System Description: CH PLASTIC -- D. BOX
Repair System Description: SAME
Maintenance Agreement Required: [ ] Yes [X] No


[X] House/Mod. Home No. Bedrooms 4
[ ] Mobile Home No. Bathrooms 3
[ ] Business No. Employees ____
[ ] Other ____
[ ] Slab [X] Crawl Space [ ] Basement w/plumbing [ ] Basement wo/plumbing

Water Supply: [ ] Individual [X] Community [ ] Public


Comments:

Comments:

INITIAL SITE SKETCH

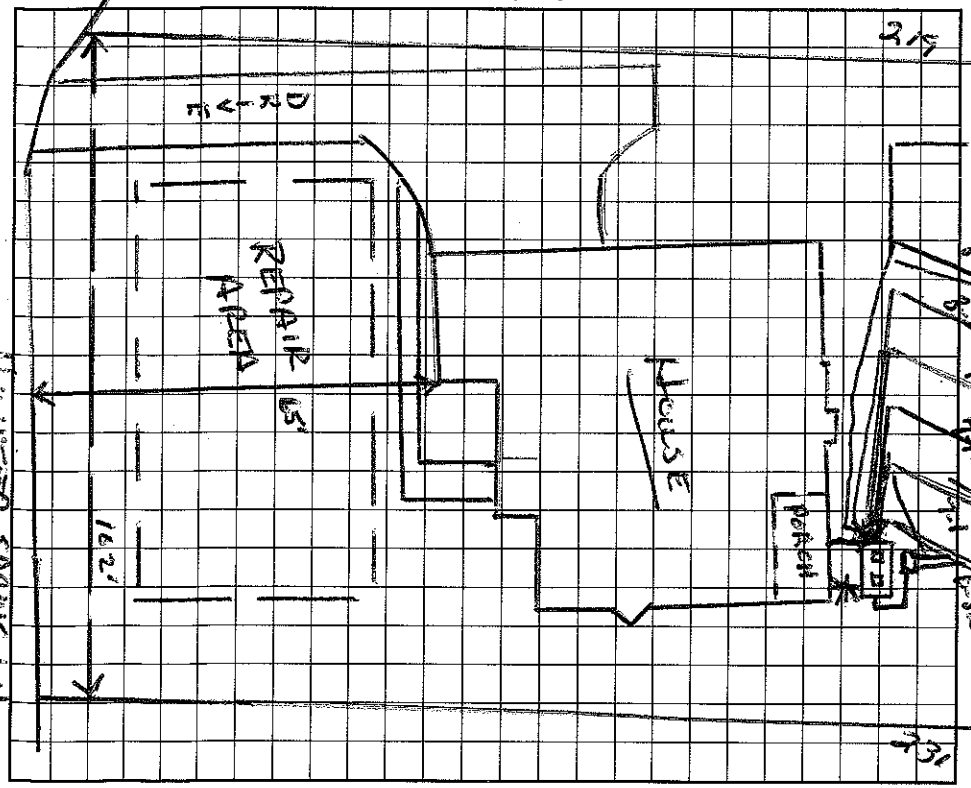

AS BUILT SKETCH

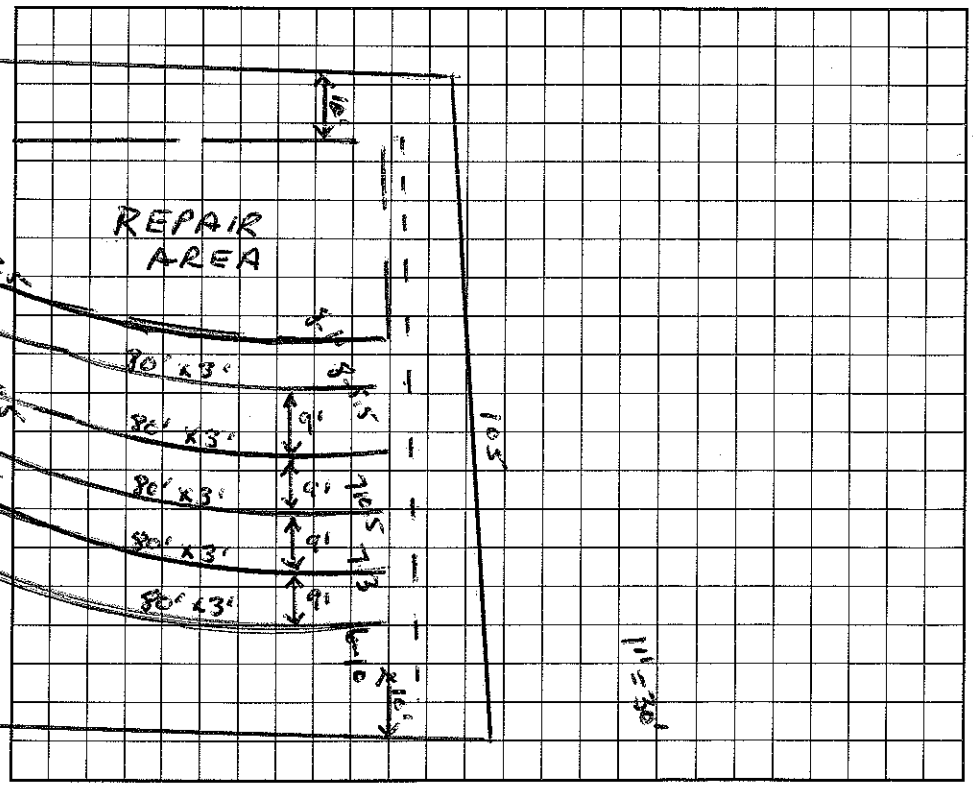

I understand that this permit can be suspended or revoked if any false information is supplied toward securing the permit/any unauthorized changes are made to the site/any unauthorized changes are made in the installation of the system.

Signed: X Tony C Jack (PS) (R) 10-25-96 Installed by: Mackey & Coyt.

Improvement Permit by: Wesley Sparks RS. date 10/25/96 Certificate of Completion by: Wesley Sparks RS. date 3/25/97

Existing System Inspection by: Wesley Sparks RS. date 10/25/96 Operation Permit by: Wesley Sparks RS. date 3/25/97

HEALTH DEPT. COPY: WHITE INSPECTION COPY (FINAL): GREEN OWNER COPY (FINAL): YELLOW INSPECTION COPY (INITIAL): PINK OWNER COPY (INITIAL): GOLD