IREDELL COUNTY HEALTH DEPARTMENT

AUTHORIZATION TO CONSTRUCT

STATESVILLE 704-878-5305 MOORESVILLE 704-664-5281

IMPROVEMENT PERMIT / ~~CERTIFICATE OF COMPLETION~~ / OPERATION PERMIT / EXISTING SYSTEM INSPECTION

PROPERTY DESCRIPTION NO. 26259 DATE 3/25/97 TAX MAP NO. 4625459263 4625-48-9265 Watershed: ☑ Yes ☐ No

OWNER OR CONTRACTOR MI HOMES PHONE: Business 663-6905 Home

ADDRESS 1043 E MOREHEAD ST CHARLOTTE NC

LOCATION BRAWLEY SCHOOL RD - TR BAY HARBOUR - TL LAKE MIST - TR CYPRESS LN AT END ON LT.

SUBDIVISION HARBOUR BLOCK / SECTION II LOT 45 LOT AREA 54742 Ft² SITE CLASS. PS DESIGN FLOW 480GAD L.T.A.R. .30 FO/FT²

Septic Tank: 1000 Gallons; STB 794 Date 1/26/99

Pump Tank: 1000 Gallons; PT 27 Date 3/16/99

Pump Make: HYDROMATIC Model SHEF50A Serial No. 3/99

Nitrification Field: No Fields 1 Square Feet 1206 Linear Feet 402

No Lines 6@67' Trench Width 36" Max Trench Bottom Depth 36" Gravel Depth ~~STONE~~ SAND

☑ New System ☐ Repair System Type: I, II, (III) IV, V, VI

System Description: PUMP CHAMBERS OR SIMILAR

Repair System Description: SAME

Maintenance Agreement Required: ☐ Yes ☑ No

☑ House/Mod. Home ☐ Mobile Home ☐ Business ☐ Other

No. Bedrooms 4 No. Bathrooms 3.5 No. Employees


☐ Slab ☑ Crawl Space ☐ Basement w/plumbing ☐ Basement wo/plumbing

Water Supply: ☐ Individual ☑ Community ☐ Public


Comments:

Comments:

1"=60' **INITIAL SITE SKETCH**

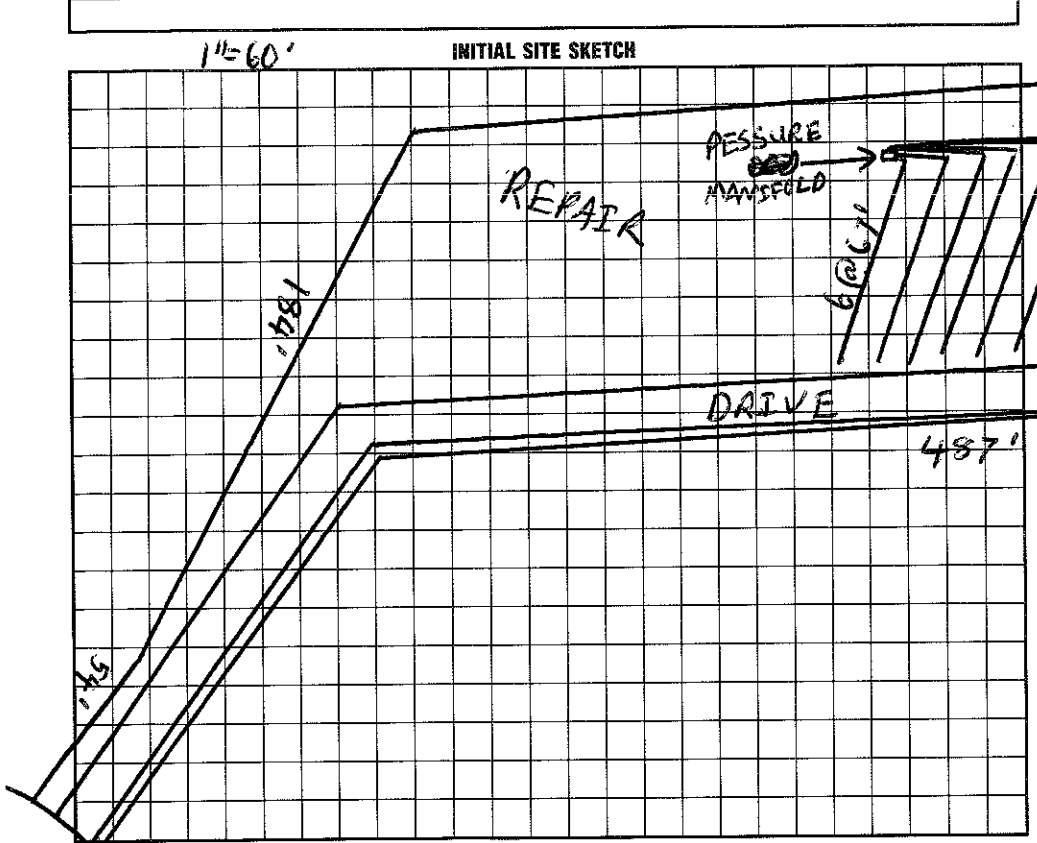

AS BUILT SKETCH

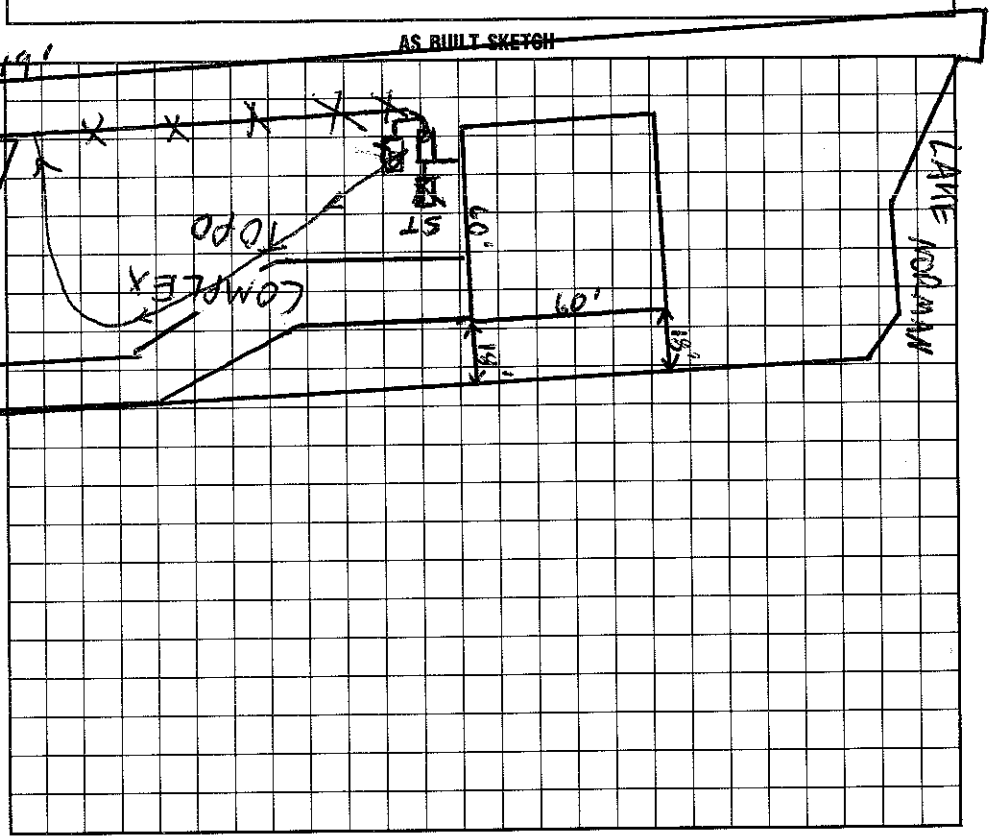

I understand that this permit can be suspended or revoked if any false information is supplied toward securing the permit/any unauthorized changes are made to the site/any unauthorized changes are made in the installation of the system. Improvement Permit is valid for 60 months from date of issuance.

Signed: Tony Gardepss

Improvement Permit by: C. Ray Freeman EHSP date 3/25/97

AUTHORIZATION TO CONSTRUCT ~~Existing System Inspection by~~: C. Ray Freeman EHS date 3/25/97

Installed by: Macleod Const

Certificate of Completion by: date

Operation Permit by: Wesley Sparks RS. date 7/26/99

HEALTH DEPT. COPY: WHITE INSPECTION COPY (FINAL): GREEN OWNER COPY (FINAL): YELLOW INSPECTION COPY (INITIAL): PINK OWNER COPY (INITIAL): GOLD