IREDELL COUNTY HEALTH DEPARTMENT

STATESVILLE 704-878-5305 MOORESVILLE 704-664-5281

IMPROVEMENT PERMIT / CERTIFICATE OF COMPLETION / OPERATION PERMIT / EXISTING SYSTEM INSPECTION

PROPERTY DESCRIPTION NO. 068477 DATE 7/10/97 TAX MAP NO. ~~4625-49-1684~~ 4625-49-0548 Watershed: ☑ Yes

OWNER OR CONTRACTOR CRESCENT RESOURCES PHONE: Business 663-6905 Home

ADDRESS 400 S. TRYON ST CHARLOTTE NC 28201

LOCATION BRAWLEY SCHOOL RD - TR BAY HARBOUR - TL SANIBEL - 3RD LOT ON LEFT

SUBDIVISION HARBOUR BLOCK / SECTION III LOT 61 LOT AREA SITE CLASS. B5 DESIGN FLOW 480 GPD L.T.A.R. .360/FT²

Septic Tank: 1000 Gallons; STB 312 Date 6/2/97

Pump Tank: Gallons; PT Date

Pump Make: Model Serial No.

Nitrification Field: No Fields 1 Square Feet 1200 Linear Feet 400

No Lines 5 @ 80' Trench Width 36" Max Trench Bottom Depth 36" Gravel Depth N/A

☑ New System ☐ Repair System Type: I, II, (III), IV, V, VI

System Description: GRAVITY CHAMBERED

Repair System Description: SAME

Maintenance Agreement Required: ☐ Yes ☑ No

☑ House/Mod. Home ☐ Mobile Home ☐ Business ☐ Other

No. Bedrooms 4 No. Bathrooms 4 No. Employees


☐ Slab ☐ Crawl Space ☑ Basement w/plumbing ☐ Basement wo/plumbing

Water Supply: ☐ Individual ☑ Community ☐ Public


Comments: OK'D HOUSE LOCATION CHANGE 5/4/99
SEE ATTACHED PLOT PLAN.

Comments:

INITIAL SITE SKETCH 11:50'

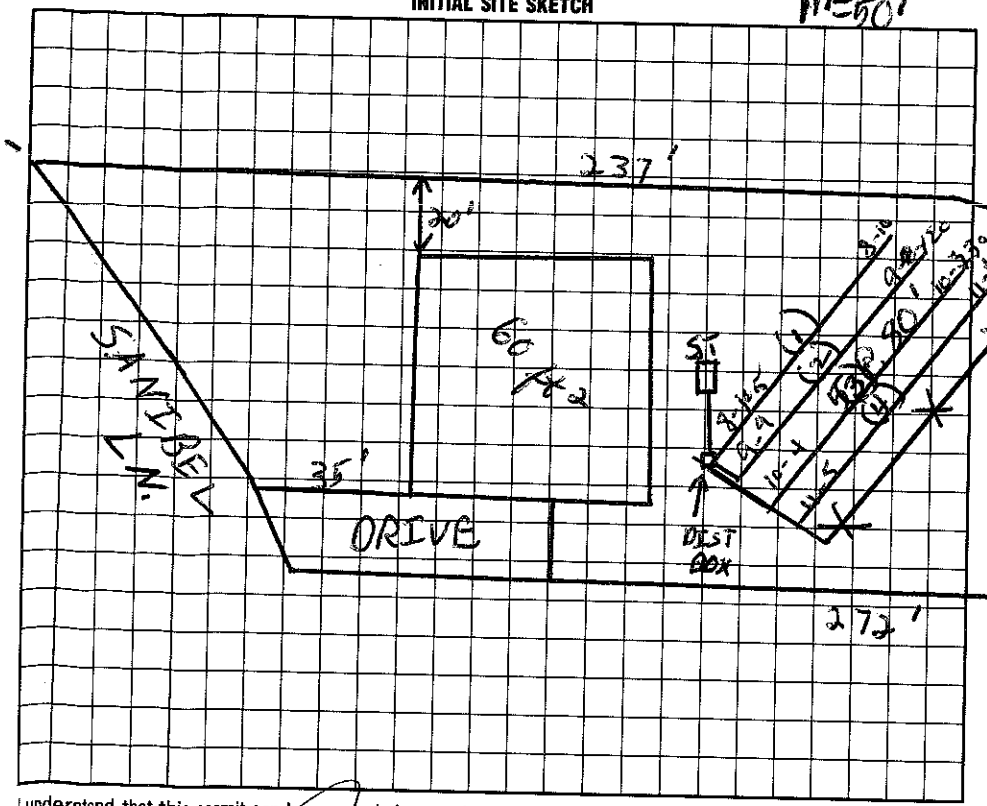

AS BUILT SKETCH

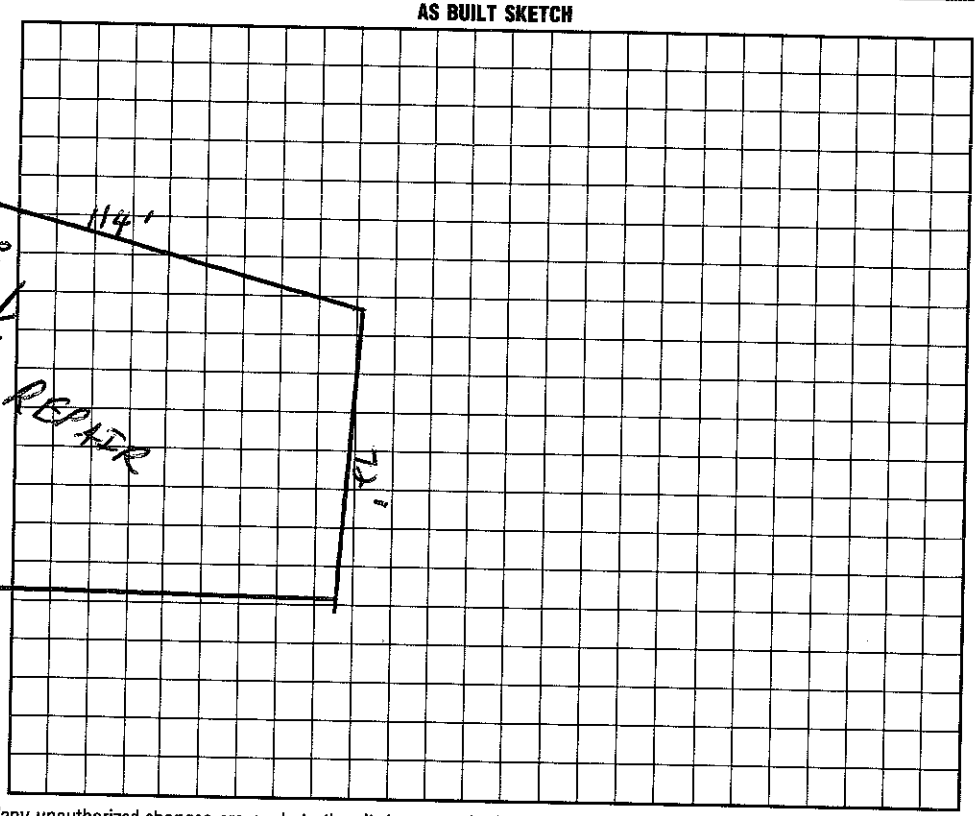

I understand that this permit can be suspended or revoked if any false information is supplied toward securing the permit/any unauthorized changes are made to the site/any unauthorized changes are made in the installation of the system. Improvement Permit is valid for 60 months from date of issuance.

Signed: [signature] 7/23/97

Improvement Permit by: [signature] date 7/14/97

Existing System Inspection by: Wesley Sparks RS date 4/9/98

Installed by: Denver Plumbing

Certificate of Completion by: Maria H. Watson date 8/23/99

Operation Permit by: Maria H. Watson RS date 8/23/

HEALTH DEPT. COPY: WHITE INSPECTION COPY (FINAL): GREEN OWNER COPY (FINAL): YELLOW INSPECTION COPY (INITIAL): PINK OWNER COPY (INITIAL): GOLD