IREDELL COUNTY HEALTH DEPARTMENT Const. Auth. STATESVILLE 704-878-5305 MOORESVILLE 704-664-5281

IMPROVEMENT PERMIT / ~~CERTIFICATE OF COMPLETION~~ / OPERATION PERMIT / EXISTING SYSTEM INSPECTION

PROPERTY DESCRIPTION NO. 23374 DATE June 11, '96 TAX MAP NO. part of 2CA3 Watershed: ☑ Yes ☐ No

OWNER OR CONTRACTOR ~~Crescent Resources Corp~~ BAUSS & BURBANK PHONE: ~~Business~~ 4625-49-0802 Home

ADDRESS PO Box 1003 Charlotte

LOCATION Brawley Sch Rd TR Bay Harbour Rd. 4th lot on left past Bonner Lane

SUBDIVISION The Harbour BLOCK / SECTION III LOT 56 LOT AREA ~ 22,000 ft² SITE CLASS pre 1978 DESIGN FLOW 480 gpd L.T.A.R. .03

Septic Tank: 1000 Gallons; STB 794 Date 4/14/98

Pump Tank: _____ Gallons; PT _____ Date _____

Pump Make: _____ Model _____ Serial No. _____

Nitrification Field: No Fields 1 Square Feet 540 Linear Feet 270

No Lines 3→6 Trench Width 24" Max Trench Bottom Depth 30" Gravel Depth NA

☑ New System ☐ Repair System Type: I, II, III, IV, V, VI

System Description: gravity panel block

Repair System Description: grav/pumped panel block

Maintenance Agreement Required: ☐ Yes ☑ No

☑ House/Mod. Home No. Bedrooms 4

☐ Mobile Home No. Bathrooms 4

☐ Business No. Employees ____

☐ Other _____

☐ Slab ☑ Crawl Space ☐ Basement w/plumbing ☐ Basement wo/plumbing


Water Supply: ☐ Individual ☐ Community ☑ ~~Public~~

Comments:

Comments:

1"=50'

INITIAL SITE SKETCH

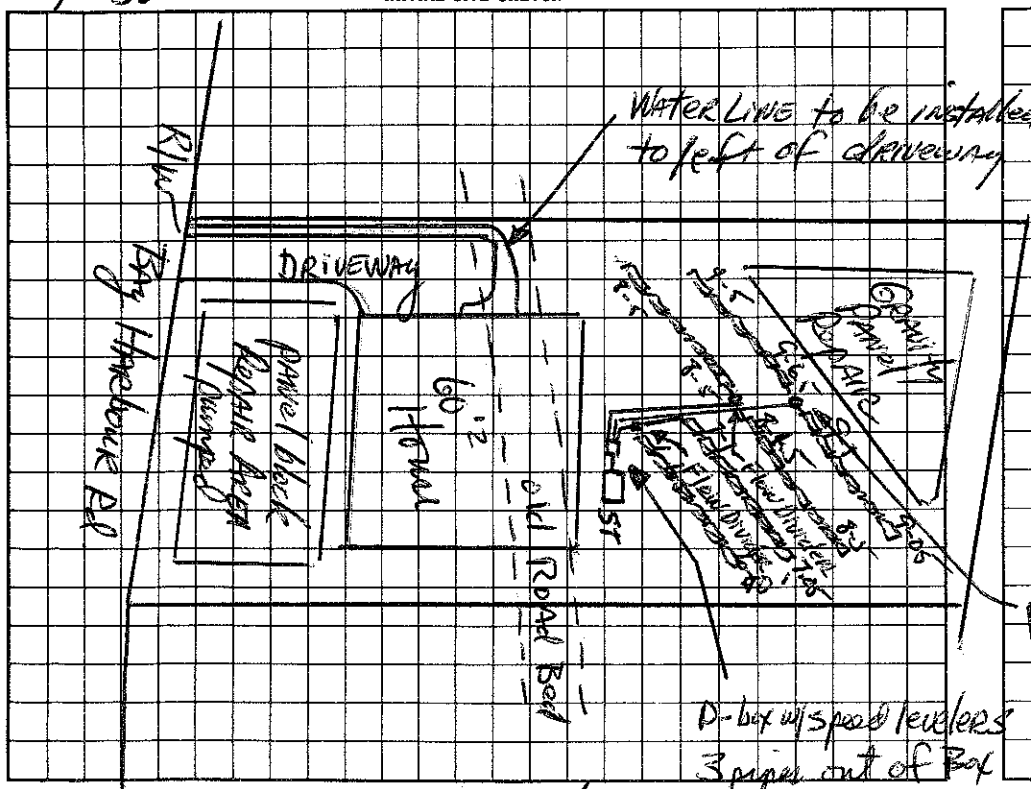

AS BUILT SKETCH

I understand that this permit can be suspended or revoked if any false information is supplied toward securing the permit/any unauthorized changes are made to the site/any unauthorized changes are made in the installation of the system.

Signed: ~~Crescent Resources Corp~~ BAUSS & BURBANK

Improvement Permit by: Jerry D. Kennon RS date 6-11-96

~~Existing System Inspection~~ Construction Authorization by: Wesley Sparks RS. date 1/5/98

Installed by: MacLeod

Certificate of Completion by: Wesley Sparks RS. date 7/17/98

Operation Permit by: Wesley Sparks RS. date 7/17/98

HEALTH DEPT. COPY: WHITE INSPECTION COPY (FINAL): GREEN OWNER COPY (FINAL): YELLOW INSPECTION COPY (INITIAL): PINK OWNER COPY (INITIAL): GOLD