IREDELL COUNTY HEALTH DEPARTMENT

STATESVILLE 704-878-5305 50.00 Paid MOORESVILLE 704-664-5281

IMPROVEMENT PERMIT / AUTHORIZATION TO CONSTRUCT / OPERATION PERMIT / EXISTING SYSTEM INSPECTION

PERMIT# 68481 PIN# 4625941684 4625-49-1202 DATE 2/15/01

OWNER OR CONTRACTOR CRESCENT RESOURCES/DOUGLAS TESTA (REGAL HOMES) PHONE: Business 660-9100 Home

ADDRESS 103 SUMMERBROOK LN. MOORESVILLE NC 28117

LOCATION BRAWLEY SCHOOL - TR BAY HARBOUR - TL SANIBEL - 7TH LOT ON LT.

SUBDIVISION THE HARBOUR BLOCK / SECTION III LOT 65 LOT AREA - SITE CLASS. PS DESIGN FLOW 480GPD L.T.A.R. .36-80/FT²

Septic Tank: 1000 Gallons; STB 312 Date 3/26/02
Pump Tank: 1000 Gallons; PT 27 Date 3/26/02
Pump Make: Goulds Model WE0 511 HT Serial No. 4/4/02
Nitrification Field: No Fields 1 Square Feet 1200 Linear Feet 400
No Lines 6@67' Trench Width 36" Max Trench Bottom Depth 36" Gravel Depth N/A

☑ New System ☐ Repair System Type: I, II, (III), IV, V, VI
System Description: Pump 25% REDUCTION
Repair System Description: LP PANEL
Maintenance Agreement Required: ☐ Yes ☑ No

☑ House/Mod. Home No. Bedrooms 4
☐ Mobile Home No. Bathrooms 4
☐ Business No. Employees
☐ Other
☐ Slab ☐ Crawl Space ☑ Basement w/plumbing ☐ Basement wo/plumbing


Water Supply: ☐ Individual ☐ Public ☑ Community

Comments:/Conditions:

Comments:/Conditions:

5/10 - Pump & Transducer installed - 5/16/02 - Pressure test & Start Up
5/14 - Drive, Sewer, Drainfield - Pond Contractor Present

INITIAL SITE SKETCH 1"=50'

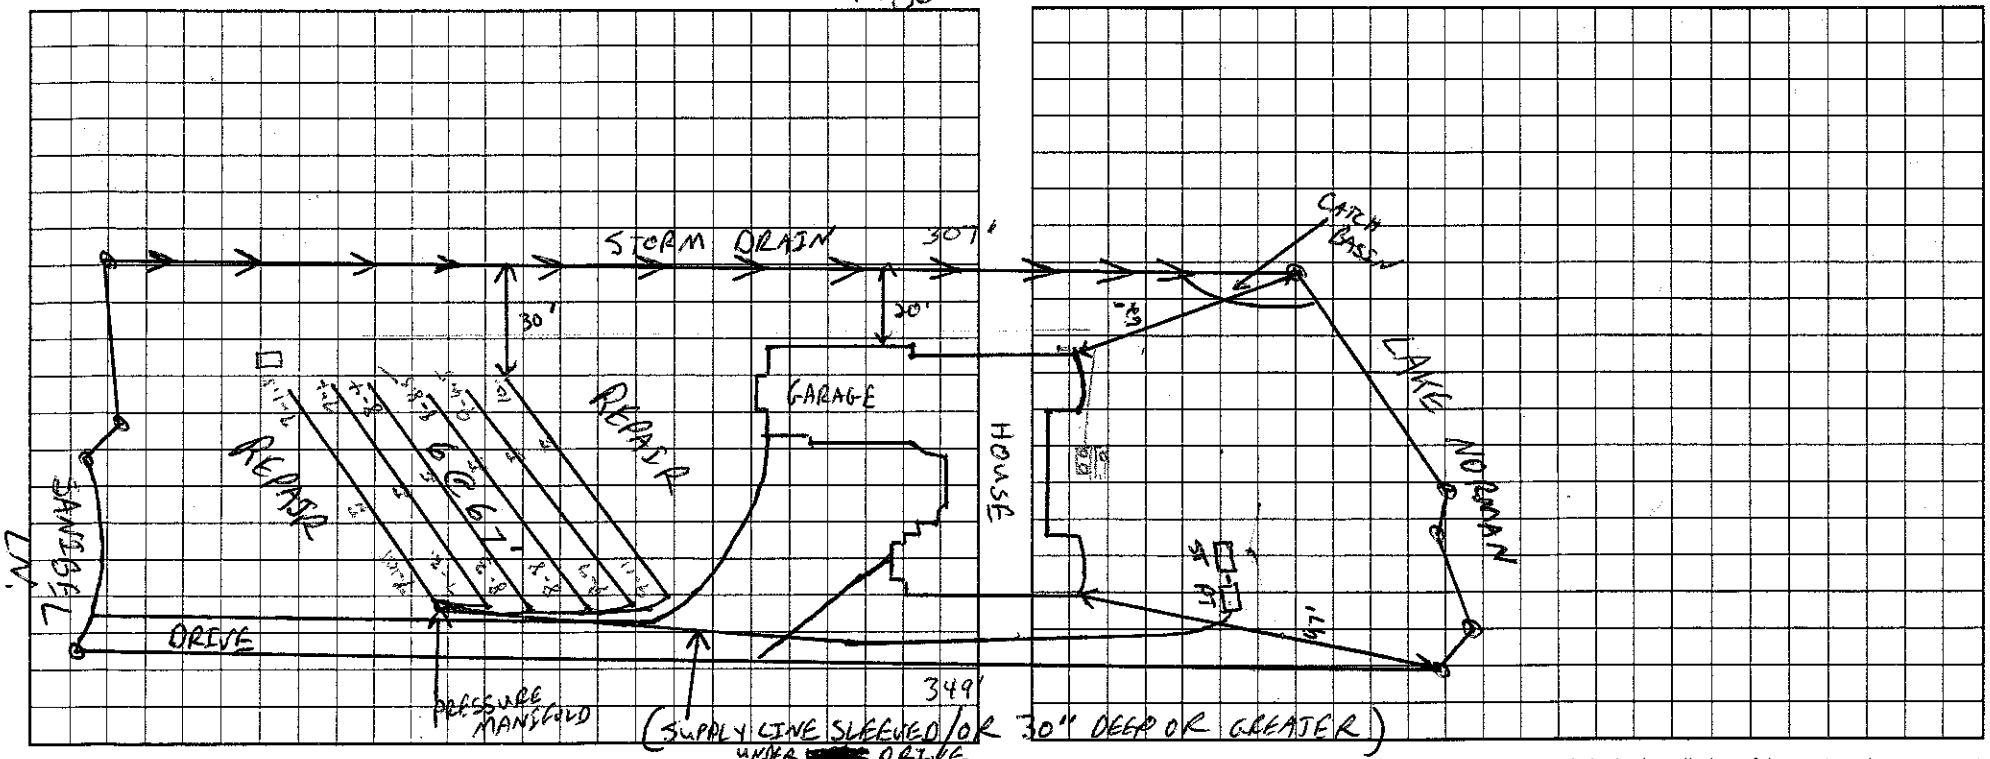

AS BUILT SKETCH

Permit can be suspended or revoked if any false information is supplied toward securing the permit/any unauthorized changes are made to the site/any unauthorized changes are made in the installation of the system. Improvement Permit with plat valid without expiration. Improvement Permit with site plan valid for sixty months. Authorization to Construct is valid for a period equal to that of Improvement Permit – not to exceed sixty months.

Signed: Douglas R Testa date

Improvement Permit by: C. Ray Teem RS date 2/15/01

Authorization to Construct by: C. Ray Teem RS date 2/15/01

Installed by: Ordinson & Sons.

Operation Permit by: Wesley Sparks RS. date 5/16/02

Existing System Inspection by: date

HEALTH DEPT. COPY: WHITE OWNER COPY (FINAL): YELLOW OWNER COPY (INITIAL): PINK