IREDELL COUNTY HEALTH DEPARTMENT

Const. Auth. STATESVILLE 704-878-5305 MOORESVILLE 704-664-5281

IMPROVEMENT PERMIT / ~~CERTIFICATE OF COMPLETION~~ / OPERATION PERMIT / EXISTING SYSTEM INSPECTION

PROPERTY DESCRIPTION NO. 23384 DATE June 13, 196 TAX MAP NO. part of 2CA3 Watershed: ☑ Yes ☐ No

OWNER OR CONTRACTOR Crescent Resources Inc / Lloyd HARTsell PHONE: Business _____ ~~Home~~ 4625-49-1500

ADDRESS PO Box 100-3 Charlotte

LOCATION Brawley Sch. Rd. TR Bay Harbour Rd. TL Swivel Ln. on left at end

SUBDIVISION The Harbour BLOCK / SECTION III LOT 62 LOT AREA ± 21,000 ft² SITE CLASS PS pre 1978 DESIGN FLOW 460 gpd L.T.A.R. .3

Septic Tank: 1000 Gallons; STB 794 Date 11-21-98

Pump Tank: _____ Gallons; PT _____ Date _____

Pump Make: _____ Model _____ Serial No. _____

Nitrification Field: No Fields 1 Square Feet 1200 Linear Feet 400

No Lines 6 Trench Width 36" Max Trench Bottom Depth 30" Gravel Depth NA

☑ New System ☐ Repair System Type: I. II. III. IV. V. VI

System Description: gravity chambered

Repair System Description: 1 LP 1 panel block

Maintenance Agreement Required: ☐ Yes ~~☐ No~~

☑ House/Mod. Home No. Bedrooms 4

☐ Mobile Home No. Bathrooms 4

☐ Business No. Employees ____

☐ Other _____

☐ Slab ☑ Crawl Space ☐ Basement w/plumbing ☐ Basement wo/plumbing


Water Supply:
☐ Individual
☐ Community
☑ Public

Comments:


Comments:

1" = 50'

INITIAL SITE SKETCH

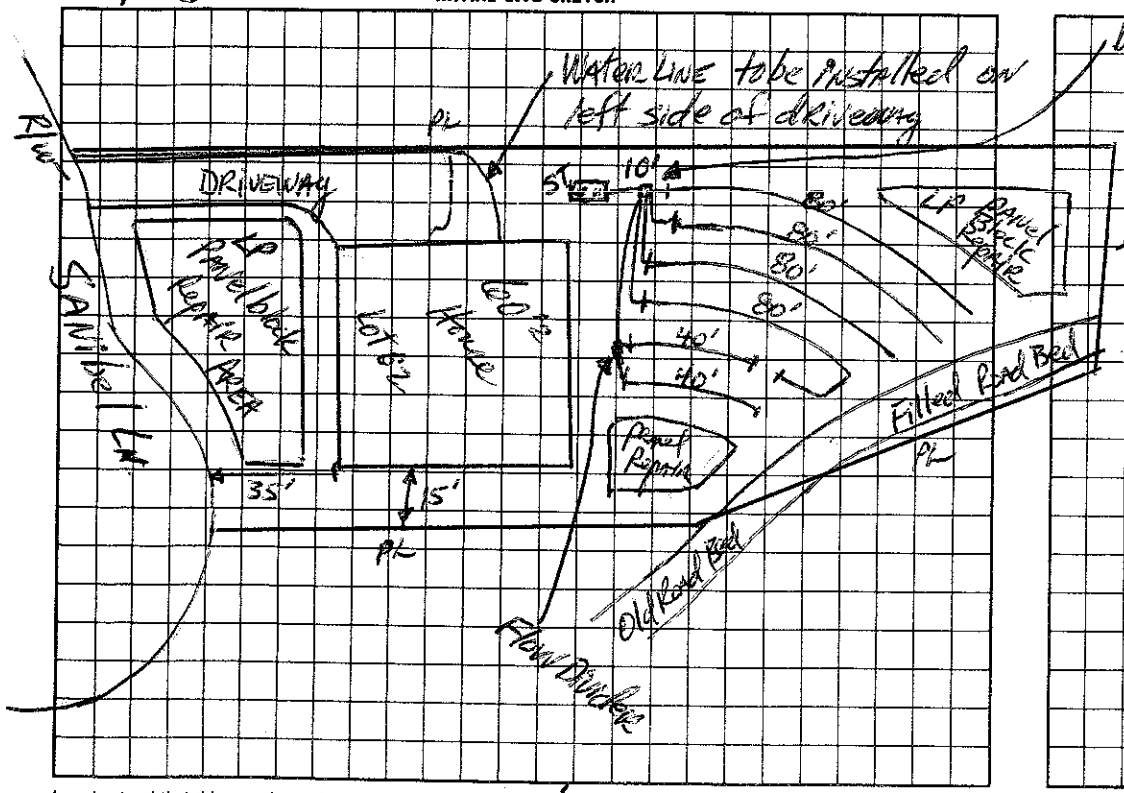

AS BUILT SKETCH

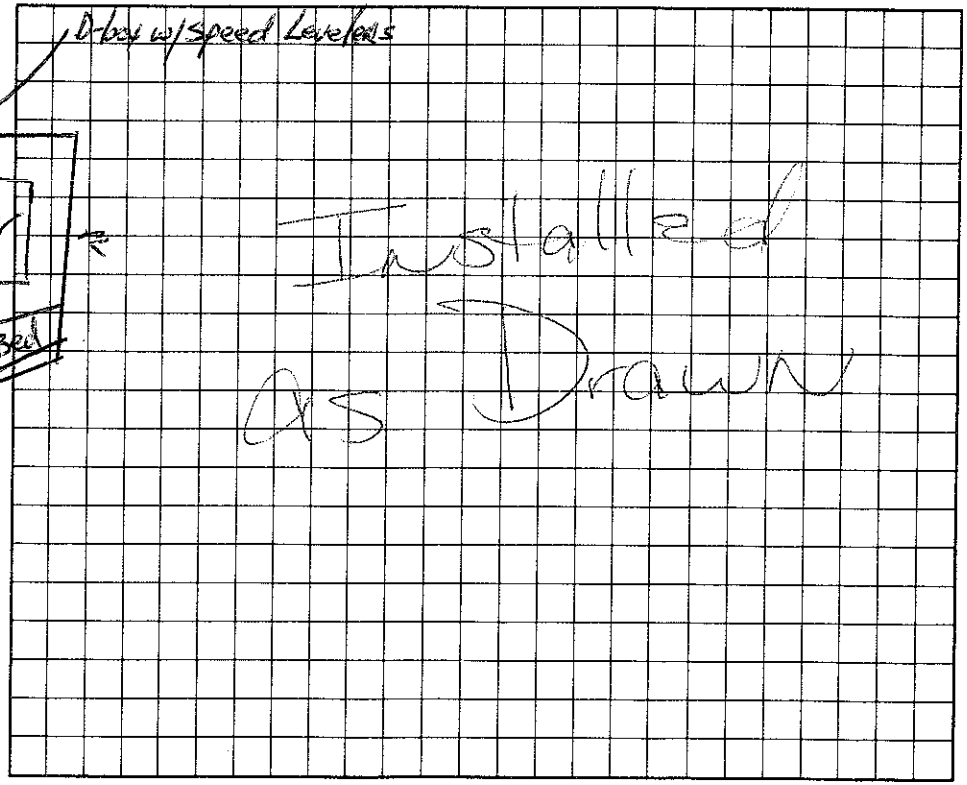

I understand that this permit can be suspended or revoked if any false information is supplied toward securing the permit/any unauthorized changes are made to the site/any unauthorized changes are made in the installation of the system.

Signed: Tracy E. Mayk, CPSS

Improvement Permit by: Mark Johnson, RS date 6-13-96

~~Construction~~ Authorization by: Mark Johnson, RS date 6-25-98

Installed by: Curt Dunning

Certificate of Completion by: Mark Johnson R.S. date 1/6/99

Operation Permit by: Mark Johnson RS date 1/6/99

HEALTH DEPT. COPY: WHITE INSPECTION COPY (FINAL): GREEN OWNER COPY (FINAL): YELLOW INSPECTION COPY (INITIAL): PINK OWNER COPY (INITIAL): GOLD