IREDELL COUNTY HEALTH DEPARTMENT

Const. Auth. STATESVILLE 704-878-5305 MOORESVILLE 704-664-5281

IMPROVEMENT PERMIT / ~~CERTIFICATE OF COMPLETION~~ / OPERATION PERMIT / EXISTING SYSTEM INSPECTION

PROPERTY DESCRIPTION NO. 23869 DATE June 12, '96 TAX MAP NO. part of 2FC 445 Watershed: ☑ Yes ☐ No

OWNER OR CONTRACTOR Crescent Resources Inc. - Sandy Burbank PHONE: Business ____ ~~Home~~ 625-49-1811

ADDRESS PO Box 1003 Charlotte

LOCATION Brawley Sch Rd. TR Bay Harbour Rd on left 3rd lot past Bonner Lane

SUBDIVISION The Harbour BLOCK / SECTION III LOT 55 LOT AREA ~27,000 ft² SITE CLASS. PS prev. 1956 DESIGN FLOW 480 gpd L.T.A.R. .3

Septic Tank: 1000 Gallons; STB 794 Date 10/29/98

Pump Tank: ____ Gallons; PT ____ Date ____

Pump Make: ____ Model ____ Serial No. ____

Nitrification Field: No Fields 2 Square Feet 540 Linear Feet 270

No Lines 3+3 Trench Width 24" Max Trench Bottom Depth 30" Gravel Depth NA

☑ New System ☐ Repair System Type: I, II, III, IV, V, VI

System Description: gravity panel block

Repair System Description: gravity/pumped panel block

Maintenance Agreement Required: ☐ Yes ☑ No

☑ House/Mod. Home ☐ Mobile Home ☐ Business ☐ Other

No. Bedrooms 4 No. Bathrooms 4 No. Employees ____

☐ Slab ☑ Crawl Space ☐ Basement w/plumbing ☐ Basement wo/plumbing


Water Supply: ☐ Individual ☐ Community ☑ Public

Comments:


Comments:

1"=50'

INITIAL SITE SKETCH

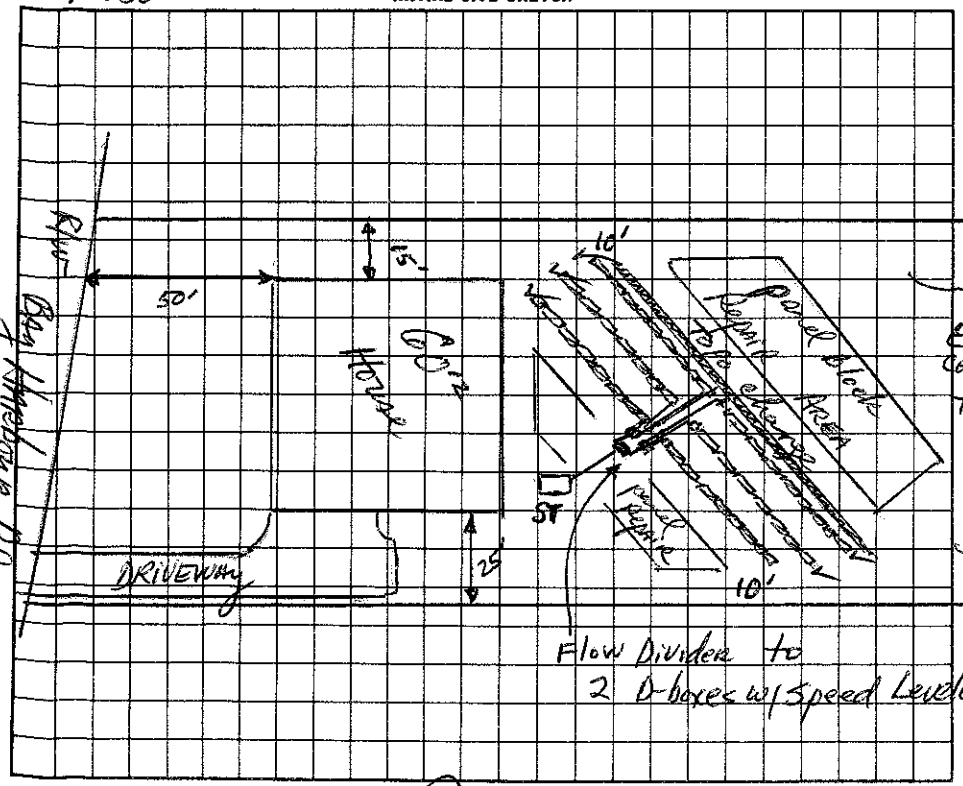

AS BUILT SKETCH

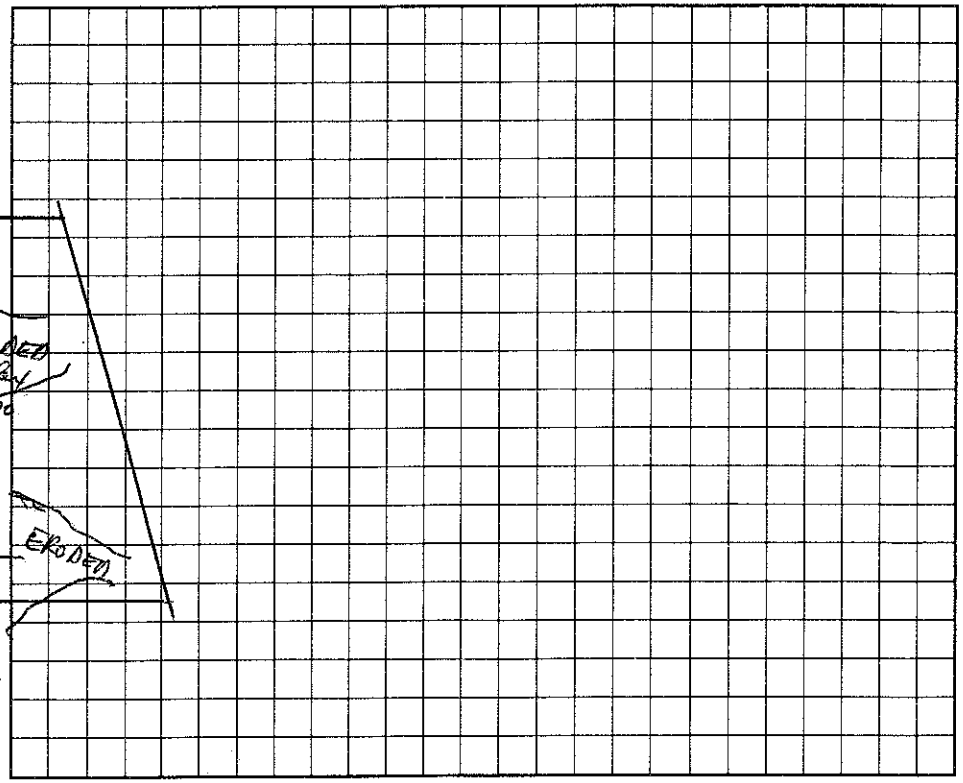

I understand that this permit can be suspended or revoked if any false information is supplied toward securing the permit/any unauthorized changes are made to the site/any unauthorized changes are made in the installation of the system.

Signed: * Troy G. Joyce, CPO

Improvement Permit by: Jeffrey D. Atkinson, IRS date 6-12-96

~~Construction Authorization~~ ~~Existing System Inspection~~ by: C. Ray Tarr date 4/13/98

Installed by: Macleod Const.

Certificate of Completion by: ____ date ____

Operation Permit by: Wesley Sparks RS date 1/22/99

HEALTH DEPT. COPY: WHITE INSPECTION COPY (FINAL): GREEN OWNER COPY (FINAL): YELLOW INSPECTION COPY (INITIAL): PINK OWNER COPY (INITIAL): GOLD