IREDELL COUNTY HEALTH DEPARTMENT Const. Auth

STATESVILLE 704-878-5305 MOORESVILLE 704-664-5281

IMPROVEMENT PERMIT / ~~CERTIFICATE OF COMPLETION~~ / OPERATION PERMIT / EXISTING SYSTEM INSPECTION

PROPERTY DESCRIPTION NO. 23385 86468 DATE June 13, '96 TAX MAP NO. part of 2643 4625492438 Watershed: ☒ Yes ☐ No

OWNER OR CONTRACTOR Crescent Resources LLC (DAVID ANGLE) PHONE: Business / Home

ADDRESS PO Box 1003 Charlotte

LOCATION Bayley Sch Rd. TR Bay Harbour Rd TL Sanibel Lane at END on left

SUBDIVISION The Harbour BLOCK / SECTION III LOT 63 LOT AREA 26,000 ft²± SITE CLASS. B per 1996 DESIGN FLOW 440 gpd L.T.A.R. .63

Septic Tank: 1000 Gallons; STB 794 Date 10/22/99

Pump Tank: 1000 Gallons; PT 283 Date 1/22/00

Pump Make: ZOELLER Model N-134B Serial No. 3/24/00

Nitrification Field: No Fields 1 Square Feet 540 Linear Feet 270

No Lines 4 Trench Width 24" Max Trench Bottom Depth 30" Gravel Depth N/A

☒ New System ☐ Repair System Type: I. II. III. IV. V.

System Description: LP panel block

Repair System Description: same

Maintenance Agreement Required: ☒ Yes ☐ No

☒ House/Mod. Home No. Bedrooms 4/4

☐ Mobile Home No. Bathrooms

☐ Business No. Employees

☐ Other


☐ Slab ☒ Crawl Space ☐ Basement w/plumbing ☐ Basement wo/plumbing

Water Supply: ☐ Individual ☐ Community ☒ Public

Comments: Central Gate Valve Box; Supply line 5' off PL 10' off Bsmt

Comments: 9.5 inch drawdown = 5" tether

INITIAL SITE SKETCH

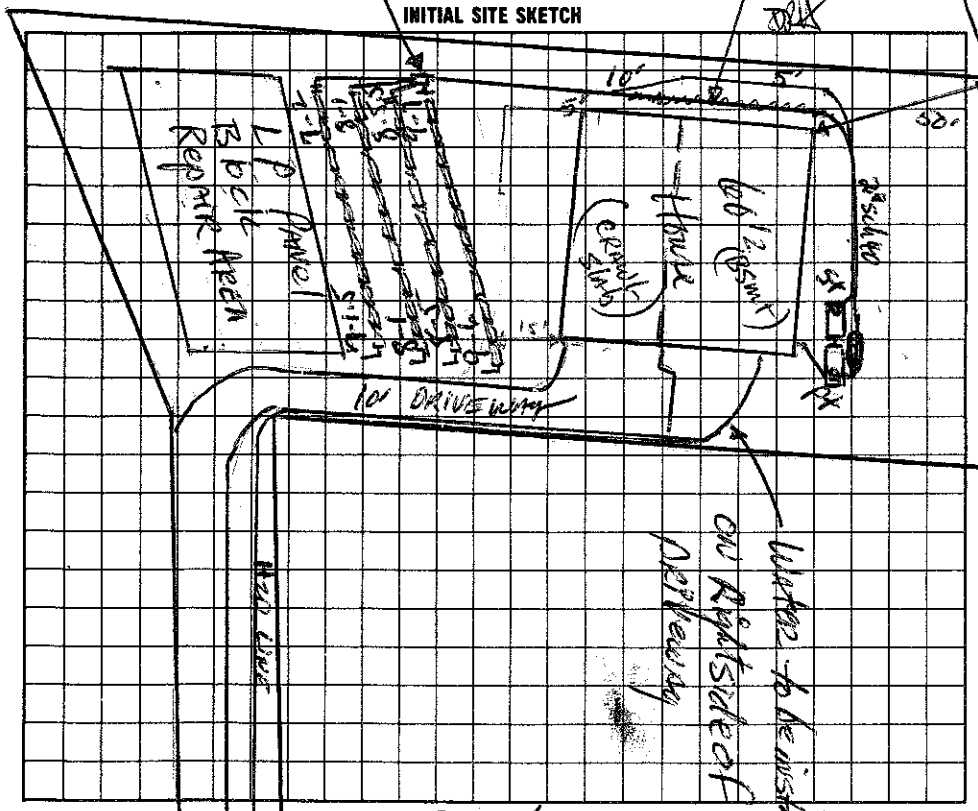

AS BUILT SKETCH 1"=50'

I understand that this permit can be suspended or revoked if any false information is supplied toward securing the permit/any unauthorized changes are made to the site/any unauthorized changes are made in the installation of the system.

Signed: [signature] CPSS

Improvement Permit by: Barry R. Thomas RS date 6-13-96

~~Existing System Inspection by:~~ Auth Const: Wesley Sparks RS date 10/1/99

Installed by: Cust Dumpsg.

Certificate of Completion by: Wesley Sparks RS. date 7/5/00

Operation Permit by: Wesley Sparks RS date 7/5/00

RW Sanibel LN.

HEALTH DEPT. COPY: WHITE INSPECTION COPY (FINAL): GREEN OWNER COPY (FINAL): YELLOW INSPECTION COPY (INITIAL): PINK OWNER COPY (INITIAL): GOLD