# IREDELL COUNTY HEALTH DEPARTMENT

Const. Auth STATESVILLE 704-878-5305 MOORESVILLE 704-664-5281

## IMPROVEMENT PERMIT / ~~CERTIFICATE OF COMPLETION~~ / OPERATION PERMIT / EXISTING SYSTEM INSPECTION

PROPERTY DESCRIPTION NO. 23868 DATE June 12, '96 TAX MAP NO. part of 2FC445 Watershed: ~~Yes~~ No

OWNER OR CONTRACTOR Crescent Resources Safeway Bullock PHONE: Business ~~Home~~ 4625-49-2812

ADDRESS PO Box 1003 Charlotte

LOCATION Brawley Sch Road TR Bay Harbour Rd 2nd lot on left past Bonner Lane

SUBDIVISION The Harbours BLOCK / SECTION III LOT 54 LOT AREA ~ 23,500 ft² SITE CLASS. PS per 1956 DESIGN FLOW 480 gpd L.T.A.R. .3

Septic Tank: 1000 Gallons; STB 794 Date 10/30/96

Pump Tank: _____ Gallons; PT _____ Date _____

Pump Make: _____ Model _____ Serial No. _____

Nitrification Field: No Fields 2 Square Feet 540 Linear Feet 270

No Lines 3+3 Trench Width 24" Max Trench Bottom Depth 30" Gravel Depth NA

☒ New System ☐ Repair System Type: I. II. III. IV. V.

System Description: gravity panel block

Repair System Description: gravity pumped panel block

Maintenance Agreement Required: ☐ Yes ☒ No

☒ House/Mod. Home No. Bedrooms 4

☐ Mobile Home No. Bathrooms 4

☐ Business No. Employees ____

☐ Other _____


☐ Slab ☒ Crawl Space ☐ Basement w/plumbing ☐ Basement wo/plumbing

Water Supply:
☐ Individual
☐ Community
☒ Public


Comments:

Comments:

### INITIAL SITE SKETCH

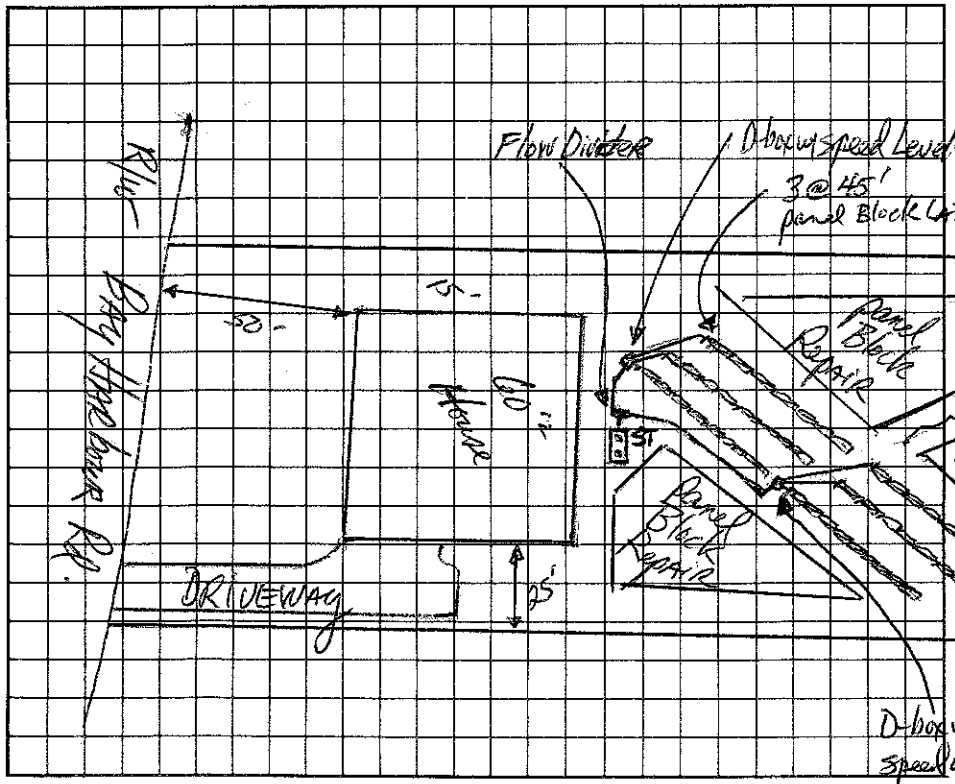


### AS BUILT SKETCH

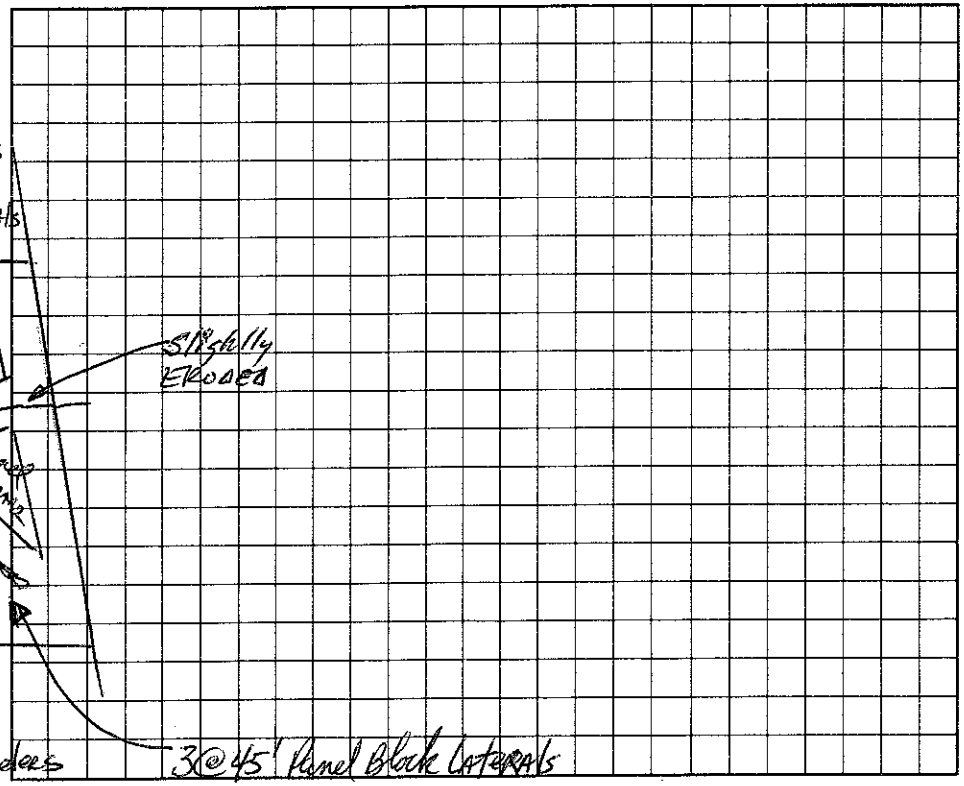


I understand that this permit can be suspended or revoked if any false information is supplied toward securing the permit/any unauthorized changes are made to the site/any unauthorized changes are made in the installation of the system.

Signed: ~~X~~ Tracy Clark CRS

Improvement Permit by: Dave Bolyard RS date 6-12-96

~~Const Auth~~ ~~Existing system inspection by:~~ Wesley Sparks RS date 11/12/96

Installed by: Macleod Const.

Certificate of Completion by: Wesley Sparks RS. date 4/7/97

Operation Permit by: Wesley Sparks RS. date 4/7/97

HEALTH DEPT. COPY: WHITE INSPECTION COPY (FINAL): GREEN OWNER COPY (FINAL): YELLOW INSPECTION COPY (INITIAL): PINK OWNER COPY (INITIAL): GOLD