IREDELL COUNTY HEALTH DEPARTMENT

STATESVILLE 704-878-5305 MOORESVILLE 704-664-5281

IMPROVEMENT PERMIT / AUTHORIZATION TO CONSTRUCT / OPERATION PERMIT / EXISTING SYSTEM INSPECTION

PERMIT# 070608 PIN# 4625493504 DATE 1/8/98

OWNER OR CONTRACTOR Sawsey Bullock PHONE: Business 365-9916 Home

ADDRESS 6525 Morrison Blvd. Charlotte NC. 28210

LOCATION 1100 TR Bay Harbour TL Bonner Ct. 1st culdesac - Right down drive

SUBDIVISION HARBOUR BLOCK / SECTION III LOT 52 LOT AREA .95Ac. SITE CLASS. PS DESIGN FLOW 480 L.T.A.R. .3

Septic Tank: 1000 Gallons; STB 794 Date 7/1/98
Pump Tank: 1000 Gallons; PT 27 Date 6/31/98
Pump Make: HYDROMATIC Model SHEF 50A1 Serial No. 7/98
Nitrification Field: No Fields 1 Square Feet 804* Linear Feet 267*
No Lines 4 Trench Width 36" Max Trench Bottom Depth 36" Gravel Depth SAND

X New System ☐ Repair System Type: I, II, III, IV, V, VI
System Description: PressMan — 16" PPBS
Repair System Description: SAME
Maintenance Agreement Required: X Yes ☐ No


X House/Mod. Home No. Bedrooms 4
☐ Mobile Home No. Bathrooms 3.5
☐ Business No. Employees
☐ Other
☐ Slab ☐ Crawl Space X Basement w/plumbing ☐ Basement wo/plumbing

Water Supply: ☐ Individual ☐ Public X Community


Comments:/Conditions: Type IV System

Comments:/Conditions:

INITIAL SITE SKETCH

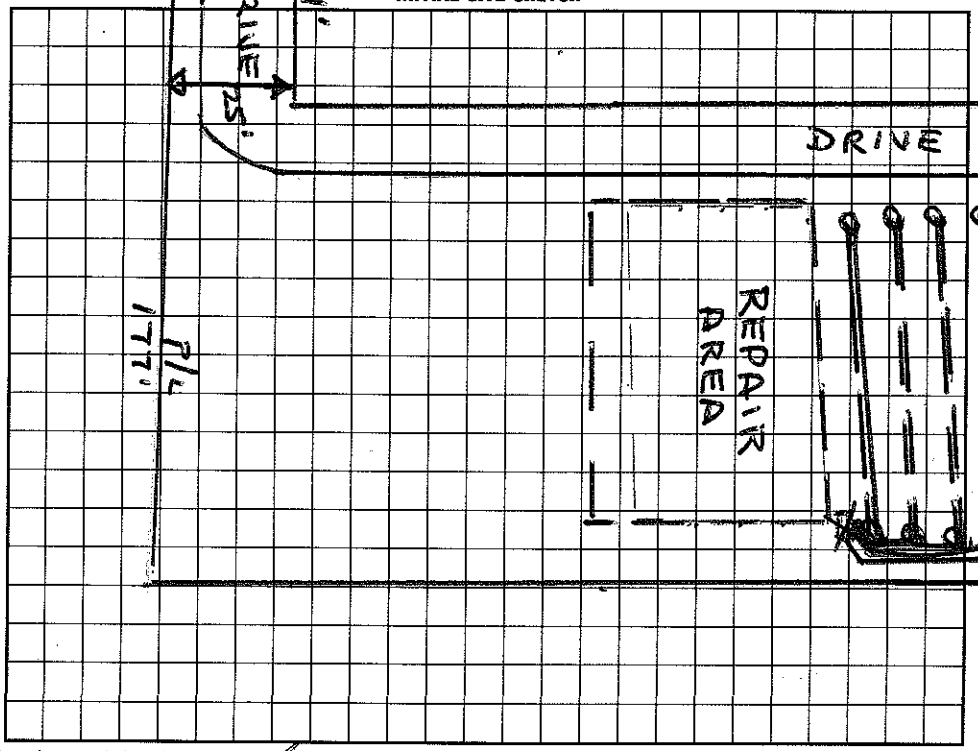

AS BUILT SKETCH

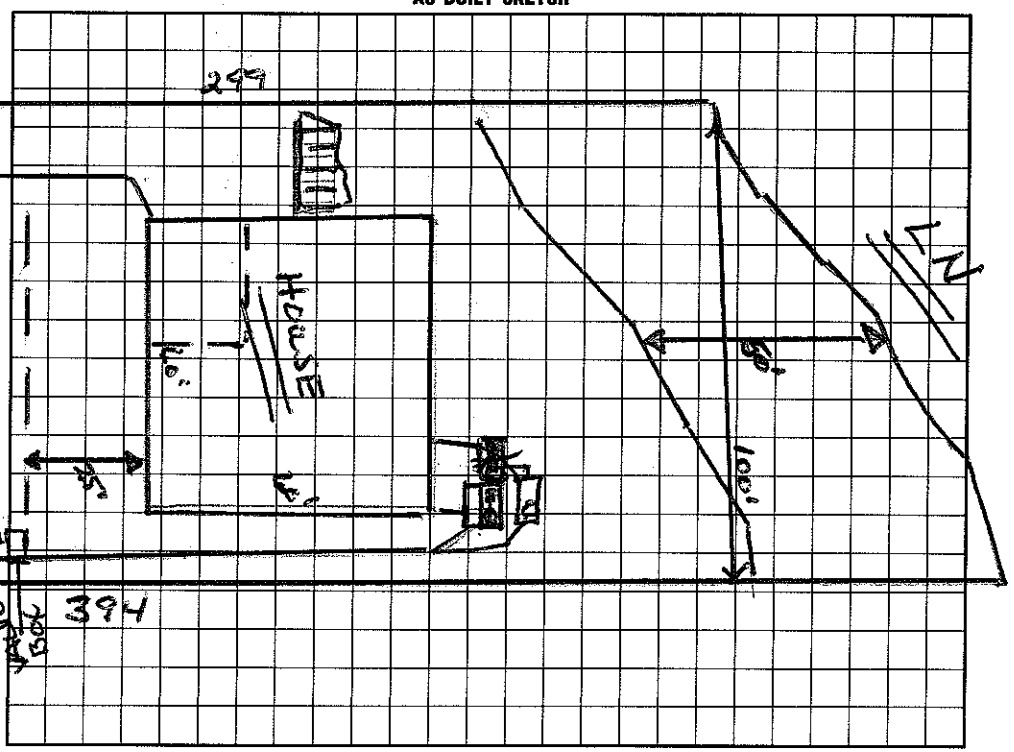

I understand that this permit can be suspended or revoked if any false information is supplied toward securing the permit/any unauthorized changes are made to the site/any unauthorized changes are made in the installation of the system. Improvement Permit with plat valid without expiration. Improvement Permit with site plan valid for sixty months. Authorization to Construct is valid for a period equal to that of Improvement Permit – not to exceed sixty months.

Signed: [signature] date 1/9/98

Improvement Permit by: Wesley Sparks R.S. date 1/8/98

Authorization to Construct by: Wesley Sparks R.S. date 1/8/98

Installed by: Markwood Const.

Operation Permit by: [signature] date 10/15/98

Existing System Inspection by: date

HEALTH DEPT. COPY: WHITE INSPECTION COPY (FINAL): GREEN OWNER COPY (FINAL): YELLOW INSPECTION COPY (INITIAL): PINK OWNER COPY (INITIAL): GOLD