...L COUNTY HEALTH DEPARTMENT

Authorization to Construct

STATESVILLE 704-878-5305 MOORESVILLE 704-664-5281

...MPROVEMENT PERMIT / ~~CERTIFICATE OF COMPLETION~~ / OPERATION PERMIT / EXISTING SYSTEM INSPECTION

PROPERTY DESCRIPTION NO. 069627 DATE 9/25/97 TAX MAP NO. 4625 49 3829 Watershed: [X] Yes [ ] No

OWNER OR CONTRACTOR Sunsey Burbank PHONE: Business 365-9916 Home

ADDRESS 6525 Morrison Blvd Charlotte, NC. 28211

LOCATION Bay Sch. TR Bay Harbour on (L) just past Bonner Lane

SUBDIVISION HARBOUR BLOCK / SECTION III LOT 53 LOT AREA .59 AC SITE CLASS. PS DESIGN FLOW 360 L.T.A.R. .3

Septic Tank: 1000 Gallons; STB 794 Date 2/17/97

Pump Tank: Gallons; PT Date

Pump Make: Model Serial No.

Nitrification Field: No Fields 1 Square Feet +900 Linear Feet + 300

No Lines 4 Trench Width 36" Max Trench Bottom Depth 36" Gravel Depth SAND.

[X] New System [ ] Repair System Type: I, II, (III) IV, V, VI

System Description: GRAV-CH PLASTIC OR HDS

Repair System Description: SAME

Maintenance Agreement Required: [X] Yes [ ] No

[X] House/Mod. Home No. Bedrooms 3

[ ] Mobile Home No. Bathrooms 3

[ ] Business No. Employees

[ ] Other


[ ] Slab [X] Crawl Space [ ] Basement w/plumbing [ ] Basement wo/plumbing

Water Supply: [ ] Individual [X] Community [ ] Public


Comments: 25% reduction for use of Chamband Plastic or HDS.

Comments:

INITIAL SITE SKETCH

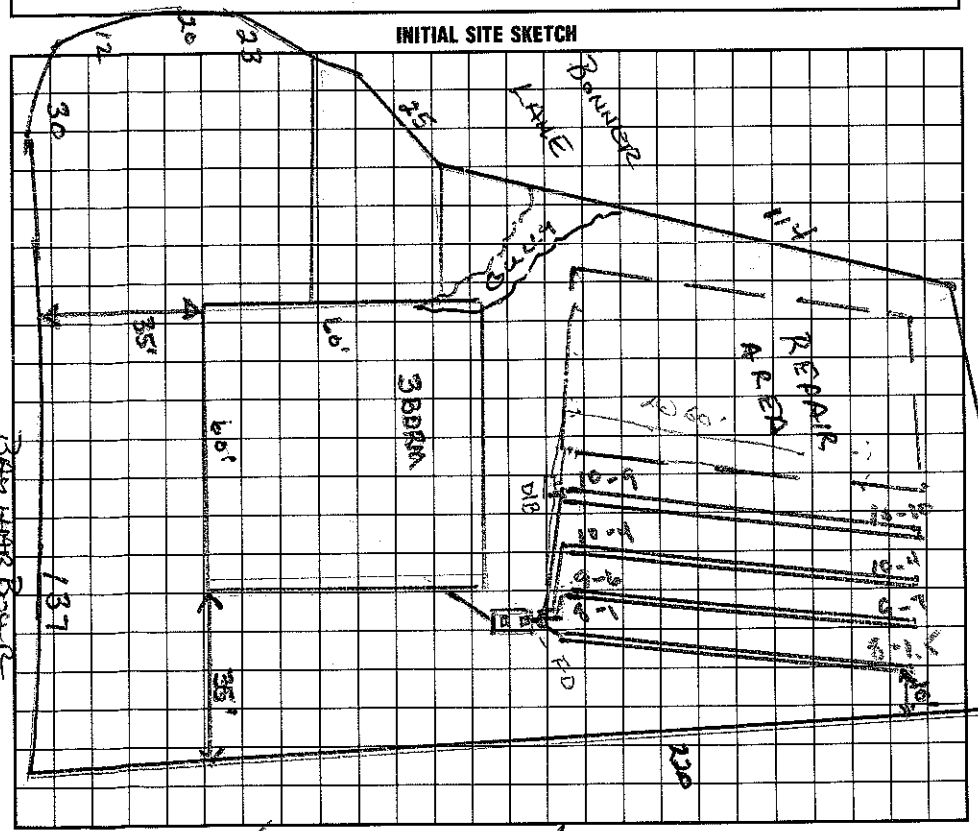

AS BUILT SKETCH

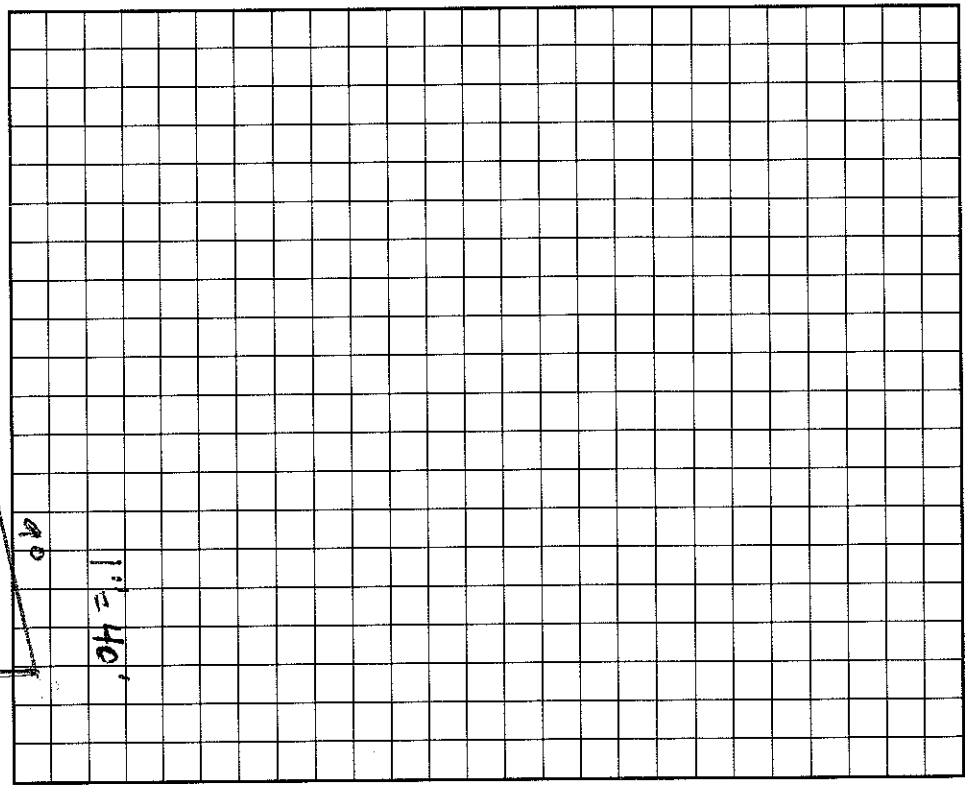

I understand that this permit can be suspended or revoked if any false information is supplied toward securing the permit/any unauthorized changes are made to the site/any unauthorized changes are made in the installation of the system. Improvement Permit is valid for 60 months from date of issuance.

Signed: [signature]

Improvement Permit by: Wesley Sparks R.S. date 9/25/97

Existing System Inspection by: Wesley Sparks R.S. date 9/25/97

Installed by: Macleod Const.

Certificate of Completion by: Wesley Sparks R.S. date 4/13/98

Operation Permit by: Wesley Sparks R.S. date 4/13/98

HEALTH DEPT. COPY: WHITE INSPECTION COPY (FINAL): GREEN OWNER COPY (FINAL): YELLOW INSPECTION COPY (INITIAL): PINK OWNER COPY (INITIAL): GOLD