IREDELL COUNTY HEALTH DEPARTMENT Const. Auth. STATESVILLE 704-878-5305 MOORESVILLE 704-663-5281

IMPROVEMENT PERMIT / ~~CERTIFICATE OF COMPLETION~~ / OPERATION PERMIT / EXISTING SYSTEM INSPECTION

PROPERTY DESCRIPTION NO. 23373 DATE June 11 '96 TAX MAP NO. part of 2CA3 4625494696 Watershed: ☑ Yes ☐ No

OWNER OR CONTRACTOR Crescent Resources Const. Sammy Bud PHONE: Business _____ Home _____

ADDRESS PO Box 1003 Charlotte

LOCATION Brawley Fork Rd. TR Bay Harbour Rd. TL Bonner Ln. at end.

SUBDIVISION The Harbour BLOCK / SECTION III LOT 50 LOT AREA 27,000 ft² ± SITE CLASS. Spec. 1996 DESIGN FLOW 480gpd L.T.A.R. .03

Septic Tank: 1000 Gallons; STB 794 Date 12/31/97
Pump Tank: 1000 Gallons; PT 27 Date 2/18/97
Pump Make: _____ Model _____ Serial No. _____
Nitrification Field: No Fields 1 Square Feet 540 Linear Feet 270
No Lines 8 Trench Width 24" Max Trench Bottom Depth 30" Gravel Depth NA

☑ New System ☐ Repair System Type: I. II. III. IV. V. VI
System Description: LP Panel Block
Repair System Description: Same
Maintenance Agreement Required: ☑ Yes ☐ No

☑ House/Mod. Home No. Bedrooms 4
☐ Mobile Home No. Bathrooms 4
☐ Business No. Employees ____
☐ Other _____
☐ Slab ☑ Crawl Space ☐ Basement w/plumbing ☐ Basement wo/plumbing


Water Supply:
☐ Individual
☐ Community
☑ Public

Comments:

Comments: 4/15/97 2 coaches on top trench bottom = Mason.
1149 - 7' drawdown

1" = 50'

INITIAL SITE SKETCH

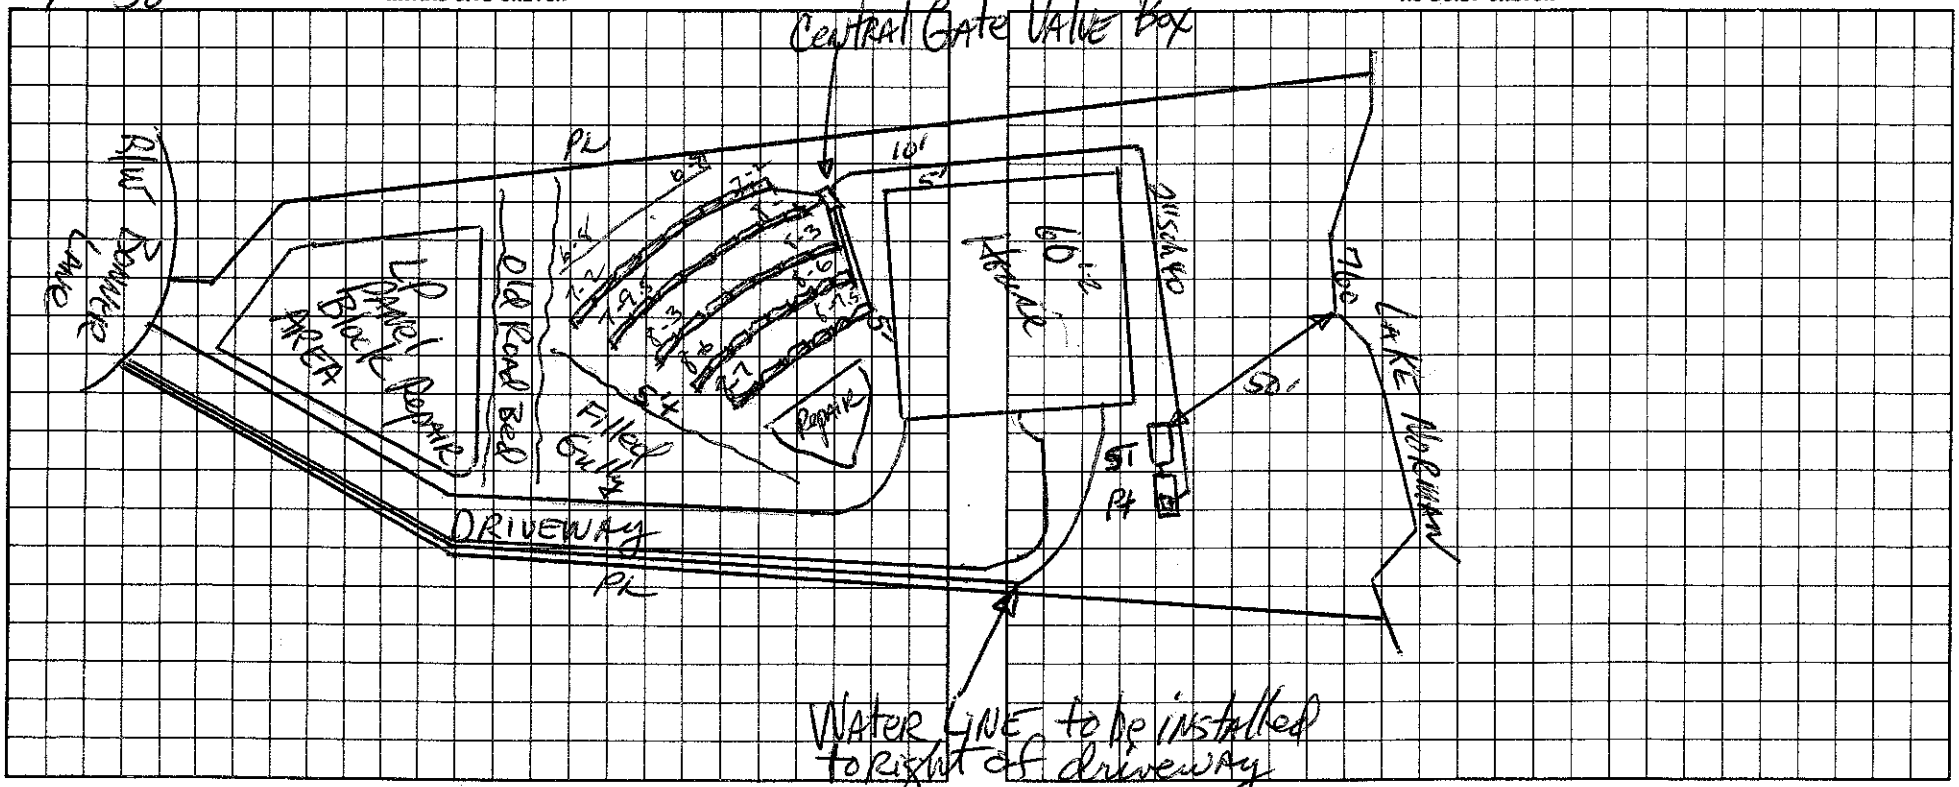

AS BUILT SKETCH

I understand that this permit can be suspended or revoked if any false information is supplied toward securing the permit/any unauthorized changes are made to the site/any unauthorized changes are made in the installation of the system.

Signed: Tony Efird, EHS

Improvement Permit by: Wesley Sparks RS date 6-10-96

~~Existing System Inspection by:~~ Construction Authorization Wesley Sparks RS date 11/12/96

Installed by: MacLeod Const.

Certificate of Completion by: Wesley Sparks RS. date 5/22/97

Operation Permit by: Wesley Sparks RS. date 5/22/97

HEALTH DEPT. COPY: WHITE INSPECTION COPY (FINAL): GREEN OWNER COPY (FINAL): YELLOW INSPECTION COPY (INITIAL): PINK OWNER COPY (INITIAL): GOLD