IREDELL COUNTY HEALTH DEPARTMENT

STATESVILLE 704-878-5305 MOORESVILLE 704-664-5281

IMPROVEMENT PERMIT / CERTIFICATE OF COMPLETION / OPERATION PERMIT / EXISTING SYSTEM INSPECTION

PROPERTY DESCRIPTION NO. 21845 DATE March 6, '96 TAX MAP NO. 2F12A39 4625495048 Watershed: ☑ Yes ☐ No

OWNER OR CONTRACTOR MI Homes PHONE: Business _____ Home _____

ADDRESS 1043 E. Morehead St #105 Charlotte

LOCATION Brawley Sch Rd TR Boy Harbour TL Lake Mist TR Sunrise Circle on Right

SUBDIVISION The Harbour BLOCK / SECTION 1 LOT 39 LOT AREA .71 Ac SITE CLASS PS per 1956 DESIGN FLOW 480 gpd L.T.A.R. ~.3

Septic Tank: 1000 Gallons; STB 794 Date 6/28/96

Pump Tank: 1000 Gallons; PT 29 Date 10/5/96

Pump Make: _____ Model _____ Serial No. _____

Nitrification Field: No. Fields 1 Square Feet 1200 Linear Feet 400

No Lines ~~6 @ 67'~~ 6 Trench Width 36" Max Trench Bottom Depth 36" Gravel Depth NA

☑ New System ☐ Repair System Type: I, II, (III), IV, V, VI

System Description: pumped - PM - Chambered LP PPBIS

Repair System Description: _____

Maintenance Agreement Required: ☐ Yes ☑ No initially

☑ House/Mod. Home No. Bedrooms 4

☐ Mobile Home No. Bathrooms 2½

☐ Business No. Employees _____

☐ Other _____

☐ Slab ☑ Crawl Space ☐ Basement w/plumbing ☐ Basement wo/plumbing


Water Supply: ☐ Individual ☐ Community ☐ Public

Comments: Type I-III fill required around chambered silts. Inspection port required on each lateral


Comments: Pressure set & electrical pending - 4/14/96 - 1/17/97

1" = 40'

INITIAL SITE SKETCH

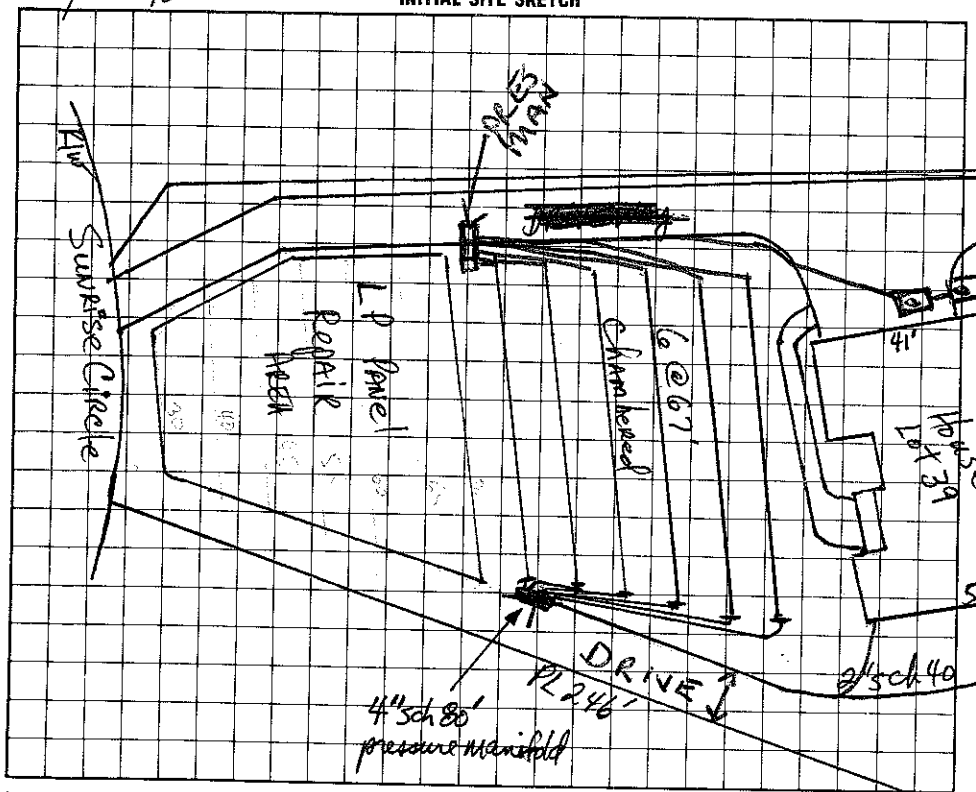

AS BUILT SKETCH

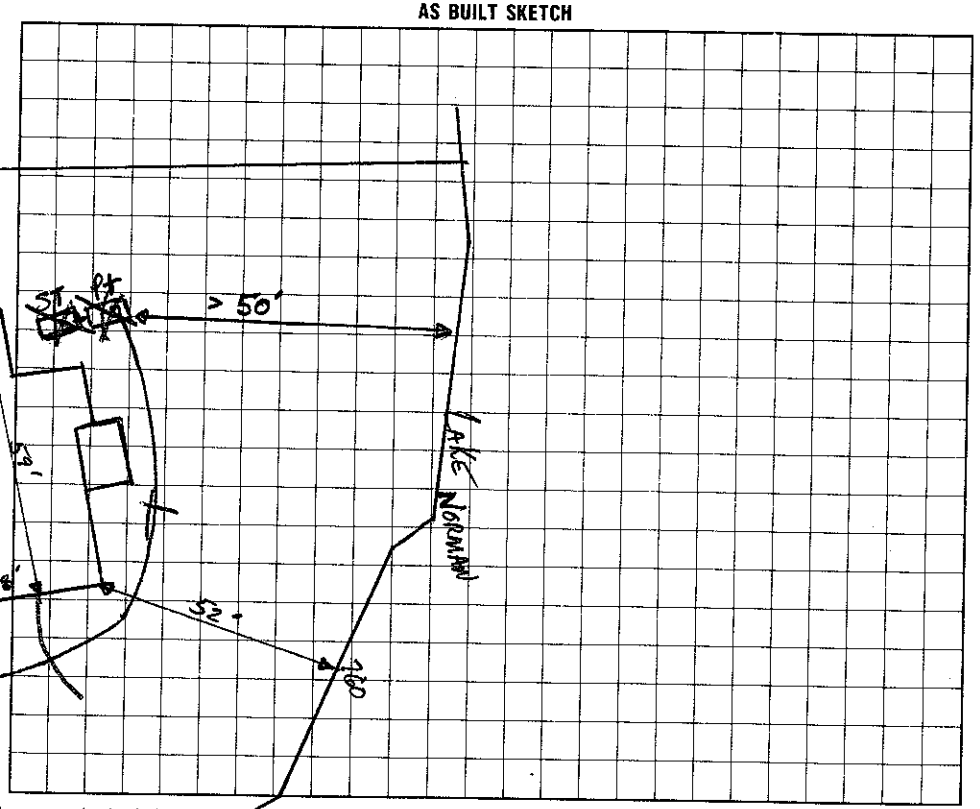

I understand that this permit can be suspended or revoked if any false information is supplied toward securing the permit/any unauthorized changes are made to the site/any unauthorized changes are made in the installation of the system.

Signed: _____

Improvement Permit by: _____ date 3-6-96

~~Existing System Inspection by:~~ authorization to construct _____ date 3-6-96

Installed by: Macheod Const. Co.

Certificate of Completion by: _____ date _____

Operation Permit by: _____ date 1/17/97

HEALTH DEPT. COPY: WHITE INSPECTION COPY (FINAL): GREEN OWNER COPY (FINAL): YELLOW INSPECTION COPY (INITIAL): PINK OWNER COPY (INITIAL): GOLD