4625 49 6278

IREDELL COUNTY HEALTH DEPARTMENT

Application to Construct

ESVILLE 704-878-5305 MOORESVILLE 704-664-5281

IMPROVEMENT PERMIT / ~~CERTIFICATE OF COMPLETION~~ / OPERATION PERMIT / EXISTING SYSTEM INSPECTION

PROPERTY DESCRIPTION NO. 19003 DATE 12/5/97 TAX MAP NO. pt of 2CA3 4625-49-6278 Watershed: [X] Yes [ ] No

OWNER OR CONTRACTOR M I Homes PHONE: Business 663-6905 Home

ADDRESS 1043 E Morehead St. Charlotte, NC.

LOCATION Brawley Sch Rd. TR Bay Harbor T-Lake W/S TR Sunrise Cir to 10th lot on (R)

SUBDIVISION HARBOUR BLOCK / SECTION MAP D LOT 41 LOT AREA 25,000 FT² SITE CLASS. PS DESIGN FLOW 480 L.T.A.R. .25

Septic Tank: 1000 Gallons; STB 794 Date 8-19-97

Pump Tank: 1000 Gallons; PT 27 Date 9-13-97

Pump Make: HYDROMATIK Model SHEF50A1 Serial No. 8-97

Nitrification Field: No Fields 1 Square Feet 640 Linear Feet 320

No Lines 3 Trench Width 24" Max Trench Bottom Depth 30" Gravel Depth SAND

[ ] New System [X] Repair System Type: I, II, III, (IV), V, VI

System Description:

Repair System Description: MOVE SEPTIC TANK

Maintenance Agreement Required: [X] Yes [ ] No

[ ] Slab [ ] Crawl Space [X] Basement w/plumbing [ ] Basement wo/plumbing

[X] House/Mod. Home No. Bedrooms 4

[ ] Mobile Home No. Bathrooms 4

[ ] Business No. Employees


[ ] Other

Water Supply:
[ ] Individual
[X] Community
[ ] Public


Comments:
MOVING SEPTIC TANK AT BUILDERS - HOME OWNERS REQUEST

Comments:

INITIAL SITE SKETCH

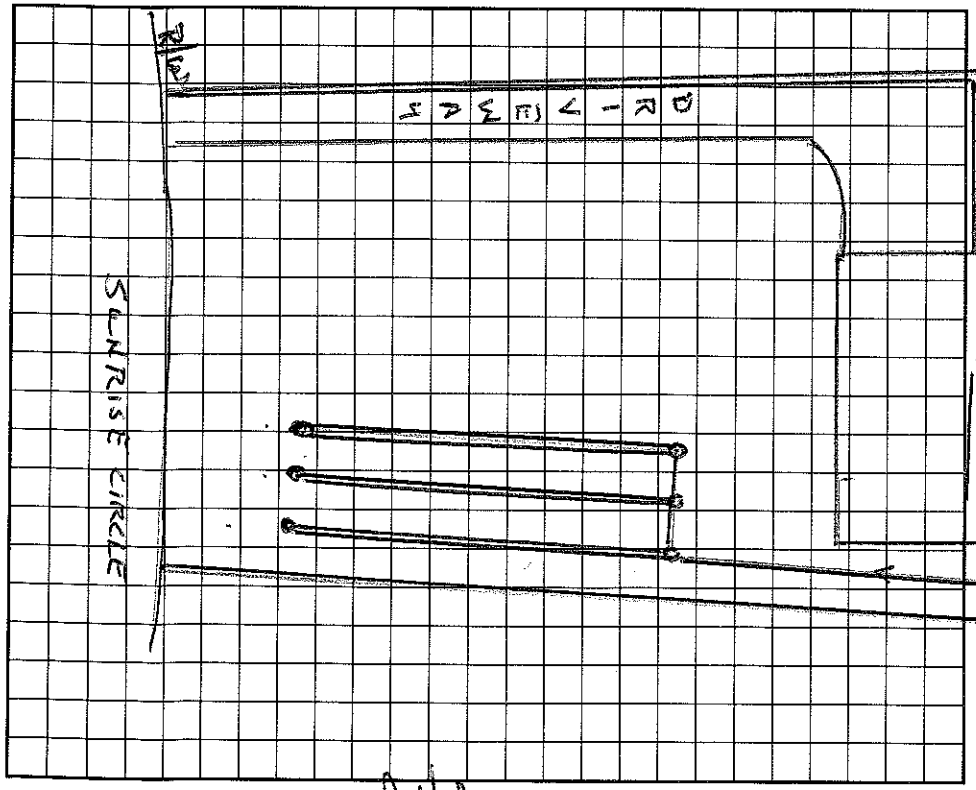

AS BUILT SKETCH

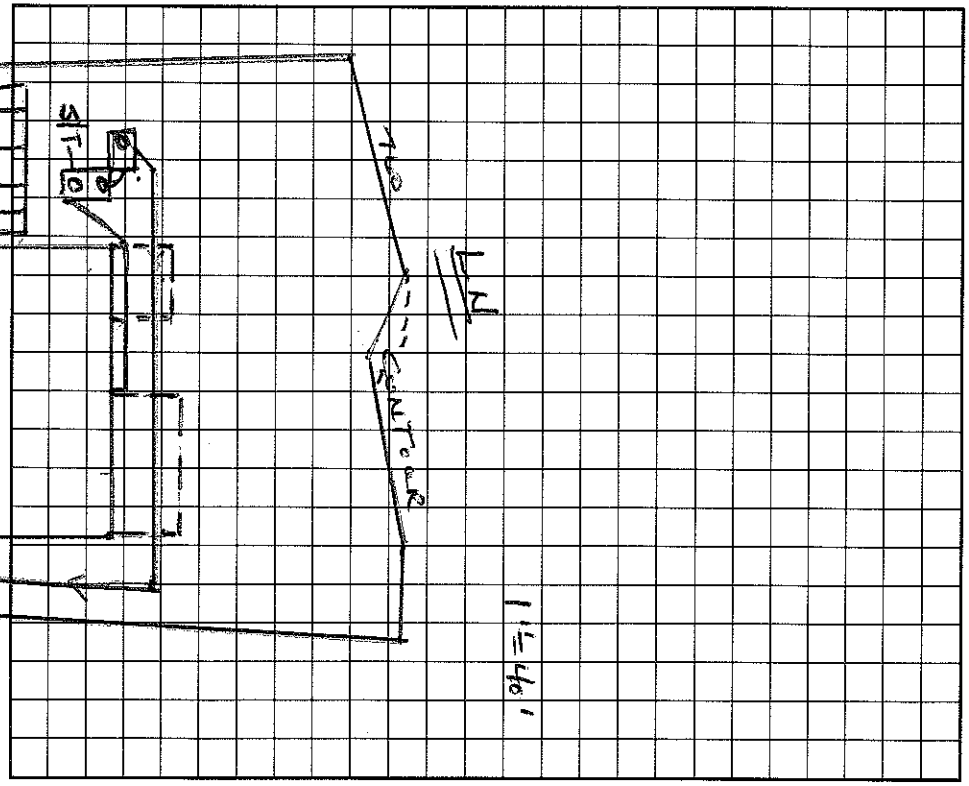

I understand that this permit can be suspended or revoked if any false information is supplied toward securing the permit/any unauthorized changes are made to the site/any unauthorized changes are made in the installation of the system. Improvement Permit is valid for 60 months from date of issuance.

Signed:

Improvement Permit by: Wesley Sparks R.S. date 12/5/97

Existing System Inspection by: Wesley Sparks R.S. date 12/5/97

Installed by:

Certificate of Completion by: Wesley Sparks R.S. date 1/6/98

Operation Permit by: Wesley Sparks R.S. date 1/6/98

HEALTH DEPT. COPY: WHITE INSPECTION COPY (FINAL): GREEN OWNER COPY (FINAL): YELLOW INSPECTION COPY (INITIAL): PINK OWNER COPY (INITIAL): GOLD