IREDELL COUNTY HEALTH DEPARTMENT

AUTHORIZATION TO CONSTRUCT

STATESVILLE 704-878-5305 MOORESVILLE 704-664-5281

IMPROVEMENT PERMIT / ~~CERTIFICATE OF COMPLETION~~ / OPERATION PERMIT / EXISTING SYSTEM INSPECTION

PROPERTY DESCRIPTION NO. 26268 DATE 7/29/97 TAX MAP NO. 4625 49 6609 Watershed: ☑ Yes ☐ No

OWNER OR CONTRACTOR SAUSSY BURBANK PHONE: Business Home 365-9916

ADDRESS 6525 MORRISON @ CHARLOTTE 28211

LOCATION BRAWLEY SCHOOL - TR BAY HARBOUR DR - TL BONNER CT - AT END IN MIDDLE OF CUL-DE-SAC

SUBDIVISION HARBOUR BLOCK / SECTION III LOT 49 LOT AREA — SITE CLASS. PS DESIGN FLOW 480 L.T.A.R. .3

Septic Tank: 1000 Gallons; STB 794 Date 2/26/98

Pump Tank: 1000 Gallons; PT 27 Date 4/19/98

Pump Make: HYDROWATIC Model SHEFSON Serial No. 5/98

Nitrification Field: No Fields 1 Square Feet 1200 Linear Feet 400

No Lines 5 @ 80 Trench Width 36" Max Trench Bottom Depth 36" Gravel Depth MA

☑ New System ☐ Repair System Type: I, II, (III) IV, V, VI

System Description: PUMP CHAMBERED

Repair System Description: PUMP PANEL

Maintenance Agreement Required: ☐ Yes ☑ No

☑ House/Mod. Home No. Bedrooms 4

☐ Mobile Home No. Bathrooms 4

☐ Business No. Employees

☐ Other

☐ Slab ☑ Crawl Space ☐ Basement w/plumbing ☐ Basement wo/plumbing


Water Supply: ☐ Individual ☑ Community ☐ Public

Comments:


Comments:

INITIAL SITE SKETCH

1"=50'

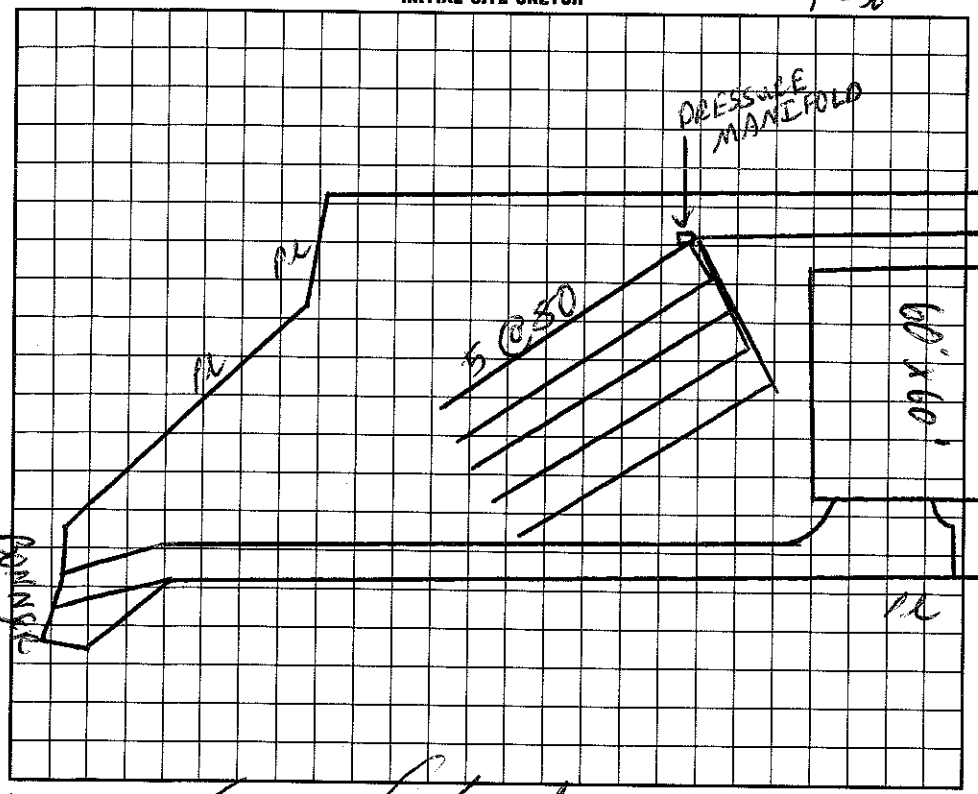

AS BUILT SKETCH

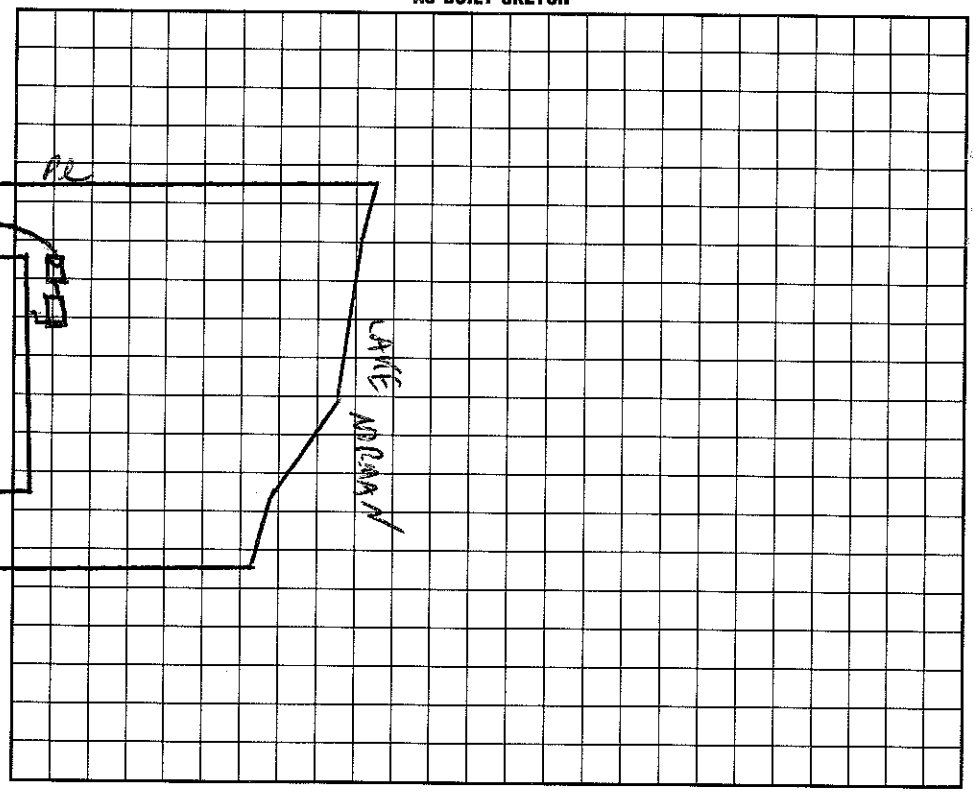

I understand that this permit can be suspended or revoked if any false information is supplied toward securing the permit/any unauthorized changes are made to the site/any unauthorized changes are made in the installation of the system. Improvement Permit is valid for 60 months from date of issuance.

Signed: [signature]

Improvement Permit by: [signature] date 7/29/97

AUTHORIZATION TO CONSTRUCT Existing System Inspection by: [signature] date 7/29/97

Installed by: Macleod Const. Co.

Certificate of Completion by: Wesley Sparks RS. date 7/14/98

Operation Permit by: Wesley Sparks RS. date 7/14/98

HEALTH DEPT. COPY: WHITE INSPECTION COPY (FINAL): GREEN OWNER COPY (FINAL): YELLOW INSPECTION COPY (INITIAL): PINK OWNER COPY (INITIAL): GOLD