(3:00)

IREDELL COUNTY HEALTH DEPARTMENT

Const. Auth. STATESVILLE 704-878-5305 MOORESVILLE 704-664-5281

IMPROVEMENT PERMIT / ~~CERTIFICATE OF COMPLETION~~ / OPERATION PERMIT / EXISTING SYSTEM INSPECTION

PROPERTY DESCRIPTION NO. 23372 DATE June 13, '96 TAX MAP NO. part of 2CA3 4625-49-6912 Watershed: ☑ Yes ☐ No

OWNER OR CONTRACTOR ~~Crescent Resources Corp~~ (SAMSON BURBANK) PHONE: Business _____ Home _____

ADDRESS PO Box 1003, Charlotte

LOCATION Brawley School Rd. TR Bay Harbour Rd. on left @ Bonner Lane

SUBDIVISION The Harbour BLOCK / SECTION III LOT 46 LOT AREA ±20,000ft² SITE CLASS. B pre-1996 DESIGN FLOW 460gpd L.T.A.R. .3

Septic Tank: 1000 Gallons; STB 794 Date 3/22/99

Pump Tank: 1000 Gallons; PT 27 Date 3/19/99

Pump Make: Hydro Model SHEF 50A Serial No. 12198

Nitrification Field: No Fields 1 Square Feet 1200 Linear Feet 400

No Lines 4@100 Trench Width 36" Max Trench Bottom Depth 36" Gravel Depth NA

☑ New System ☐ Repair System Type: I, II, (III), IV, V, VI

System Description: pumped-pm-chambered SFEA

Repair System Description: LP PPBPS SFEA

Maintenance Agreement Required: ☐ Yes ☑ No

☑ House/Mod. Home ☐ Mobile Home ☐ Business ☐ Other

No. Bedrooms 4/4 No. Bathrooms 4 No. Employees _____

☐ Slab ☑ Crawl Space ☐ Basement w/plumbing ☐ Basement wo/plumbing


Water Supply: ☐ Individual ☐ Community ☑ Public

Comments:

Comments: Changed to 2012 EZ EZ Leg to stay on contour. Installed as drawn here.

1" = 100'

INITIAL SITE SKETCH

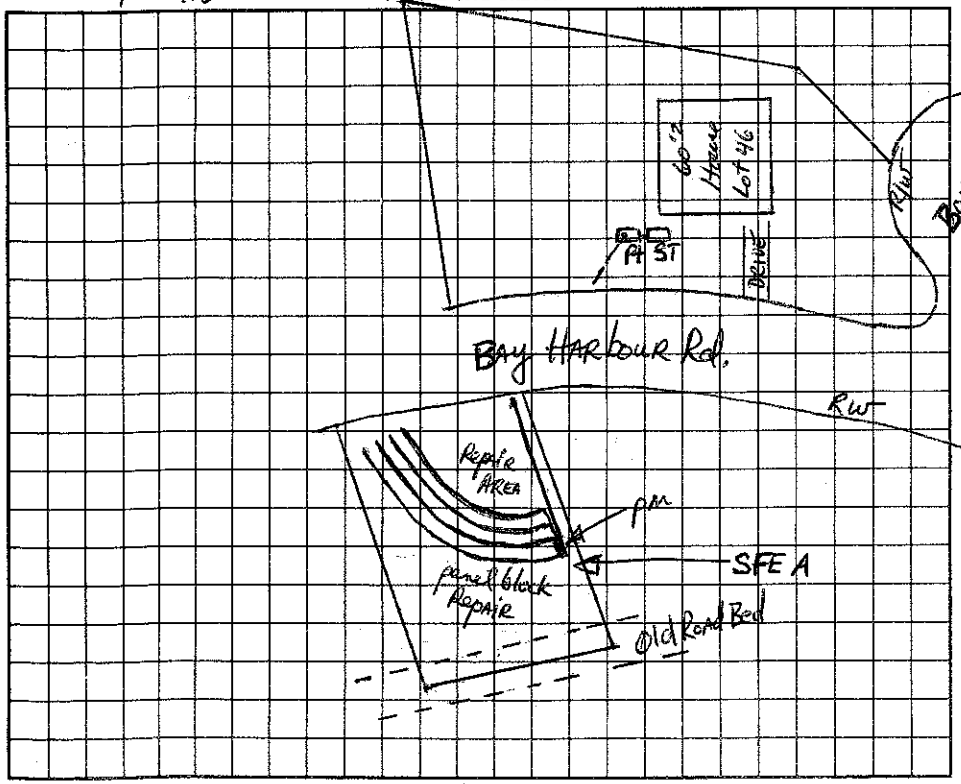

AS BUILT SKETCH

I understand that this permit can be suspended or revoked if any false information is supplied toward securing the permit/any unauthorized changes are made to the site/any unauthorized changes are made in the installation of the system.

Signed: _____

Improvement Permit by: _____ date 6-13-96

Construction/System Inspection by: Wesley Sparks RS. date 9/10/98

Installed by: Macleod Const.

Certificate of Completion by: Wesley Sparks RS. date 6/2/99

Operation Permit by: _____ date _____

HEALTH DEPT. COPY: WHITE INSPECTION COPY (FINAL): GREEN OWNER COPY (FINAL): YELLOW INSPECTION COPY (INITIAL): PINK OWNER COPY (INITIAL): GOLD