IREDELL COUNTY HEALTH DEPARTMENT

Auth To Construct

STATESVILLE 704-878-5305 MOORESVILLE 704-664-5281

3rd

IMPROVEMENT PERMIT / ~~CERTIFICATE OF COMPLETION~~ / OPERATION PERMIT / EXISTING SYSTEM INSPECTION

PROPERTY DESCRIPTION NO. 67176 DATE 6/25/97 TAX MAP NO. 4625497701 Watershed: X Yes ☐ No

OWNER OR CONTRACTOR Sammy Burbank PHONE: Business 662-3545 Home

ADDRESS 6525 Morrison Blvd. Charlotte, NC. 28211

LOCATION Brawley Sch. Rd. TR Bay Harbour Rd. TL Bonner Ct. center part of cul de sac.

SUBDIVISION HARBOUR BLOCK / SECTION III LOT 48 LOT AREA .76 SITE CLASS. PS DESIGN FLOW 480 L.T.A.R. .3

Septic Tank: 1000 Gallons; STB 794 Date 9/5/97

Pump Tank: 1000 Gallons; PT 27 Date 9/15/97

Pump Make: HYDROMATIC Model SHEF50A1 Serial No. 9-97

Nitrification Field: No Fields 1 Square Feet 1260 Linear Feet 4207

No Lines 6 Trench Width 36" Max Trench Bottom Depth 36" Gravel Depth SAND

X New System ☐ Repair System Type: I, II, (III), IV, V, VI

System Description: PRESMAN – CH PLASTIC

Repair System Description: 16"PPBS – PRESSURE

Maintenance Agreement Required: X Yes ☐ No

X House/Mod. Home ☐ Mobile Home ☐ Business ☐ Other

No. Bedrooms 4 No. Bathrooms 3 No. Employees


☐ Slab X Crawl Space ☐ Basement w/plumbing ☐ Basement wo/plumbing

Water Supply: ☐ Individual X Community ☐ Public


Comments:

Comments:

INITIAL SITE SKETCH

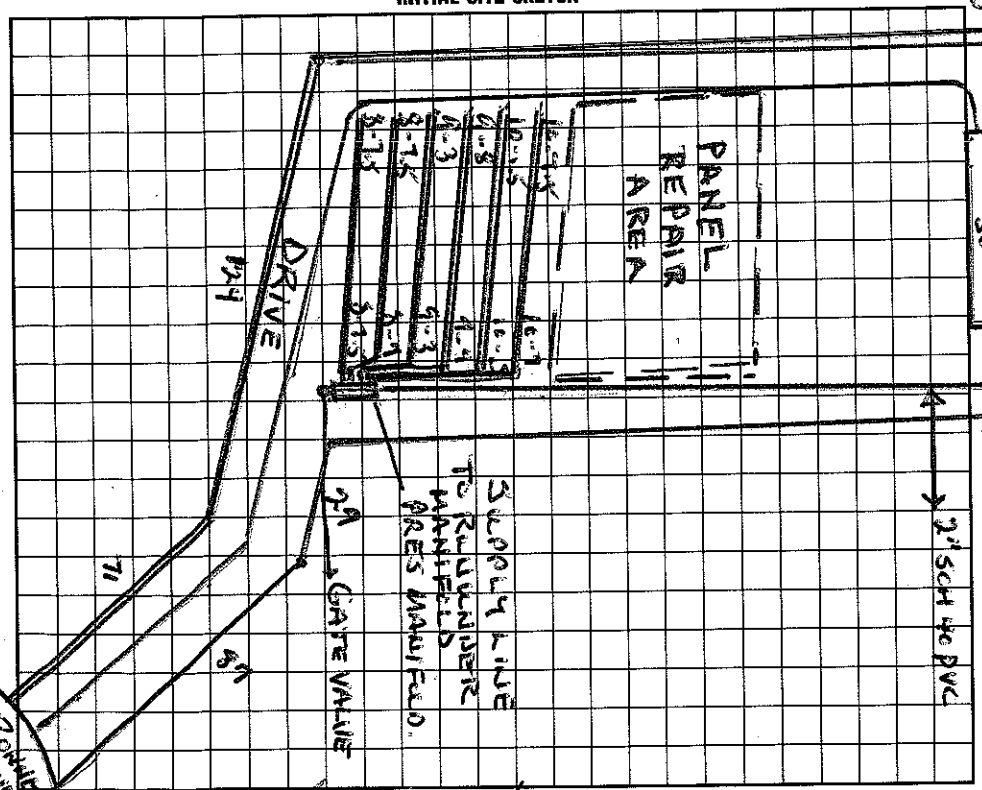

AS BUILT SKETCH

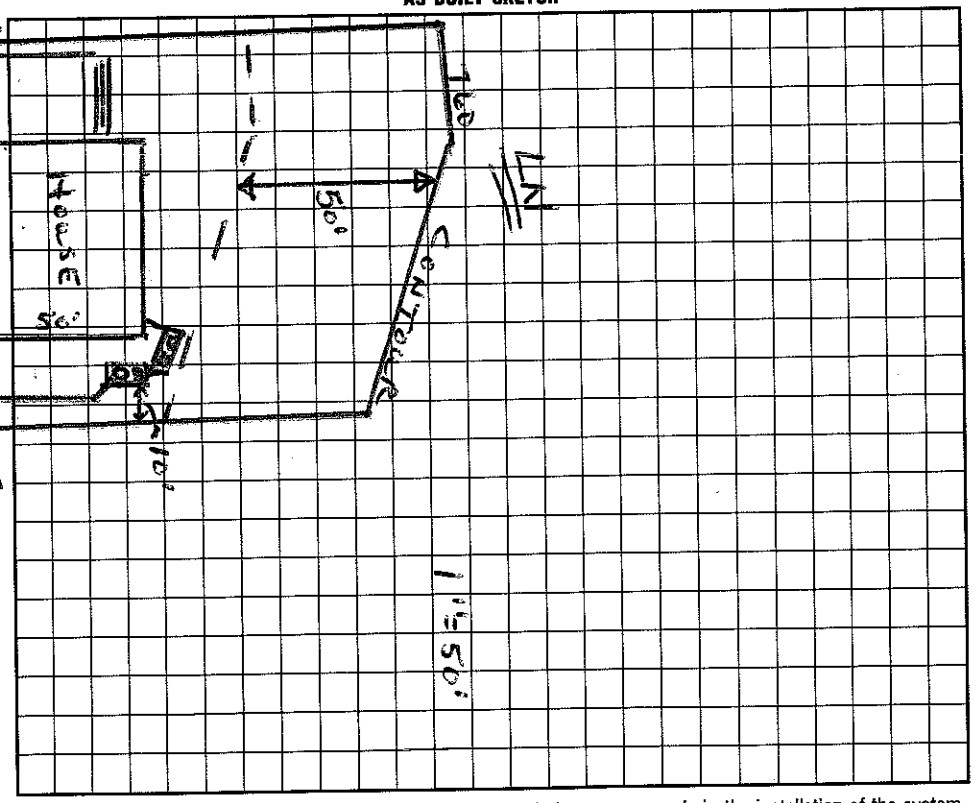

I understand that this permit can be suspended or revoked if any false information is supplied toward securing the permit/any unauthorized changes are made to the site/any unauthorized changes are made in the installation of the system. Improvement Permit is valid for 60 months from date of issuance.

Signed: X

Improvement Permit by: Wesley Sparks R.S. date 6/25/97

~~Existing System Inspection~~ by: Wesley Sparks R.S. date 6/25/97

Installed by: Macleod Cons + Co.

Certificate of Completion by: Wesley Sparks R.S. date 11/24/97

Operation Permit by: Wesley Sparks R.S. date 11/24/97

HEALTH DEPT. COPY: WHITE INSPECTION COPY (FINAL): GREEN OWNER COPY (FINAL): YELLOW INSPECTION COPY (INITIAL): PINK OWNER COPY (INITIAL): GOLD