IREDELL COUNTY HEALTH DEPARTMENT

STATESVILLE 704-878-5305 MOORESVILLE 704-664-5281

IMPROVEMENT PERMIT / AUTHORIZATION TO CONSTRUCT / OPERATION PERMIT / EXISTING SYSTEM INSPECTION

PERMIT# 073063 PIN# 4625497794 DATE 4/13/98

OWNER OR CONTRACTOR SAUSSY BURBANK PHONE: Business Home 945-1515

ADDRESS 517 SHARON AMITY SUITE 1000 CHARLOTTE NC 28211

LOCATION BAY HARBOUR - TL BONNER LN ON LT

SUBDIVISION HARBOUR BLOCK / SECTION III LOT 47 LOT AREA .85AC SITE CLASS. PS DESIGN FLOW 480GPD L.T.A.R. .30PD/FT²

Septic Tank: 1000 Gallons; STB 794 Date 9/18/98

Pump Tank: 1000 Gallons; PT 27 Date

Pump Make: Model Serial No.

Nitrification Field: No Fields 1 Square Feet 1200 Linear Feet 400

No Lines 6@67' Trench Width 36" Max Trench Bottom Depth 36" Gravel Depth MA

☑ New System ☐ Repair System Type: I, II, III, IV, V, VI

System Description: PUMP CHAMBERS OR HDS

Repair System Description: PUMP PAVEL

Maintenance Agreement Required: ☐ Yes ☑ No

☑ House/Mod. Home No. Bedrooms 4

☐ Mobile Home No. Bathrooms 4

☐ Business No. Employees

☐ Other

☐ Slab ☑ Crawl Space ☐ Basement w/plumbing ☐ Basement wo/plumbing


Water Supply: ☐ Individual ☐ Public ☑ Community

Comments:/Conditions:


1"=60'

Comments:/Conditions:

INITIAL SITE SKETCH

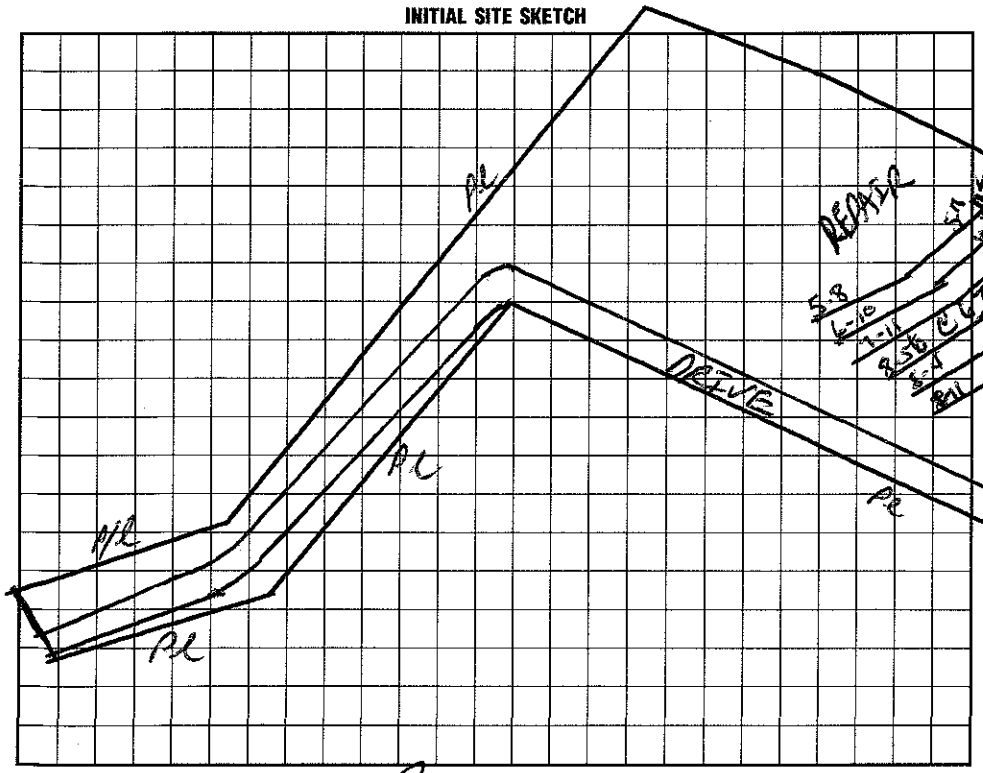

AS BUILT SKETCH

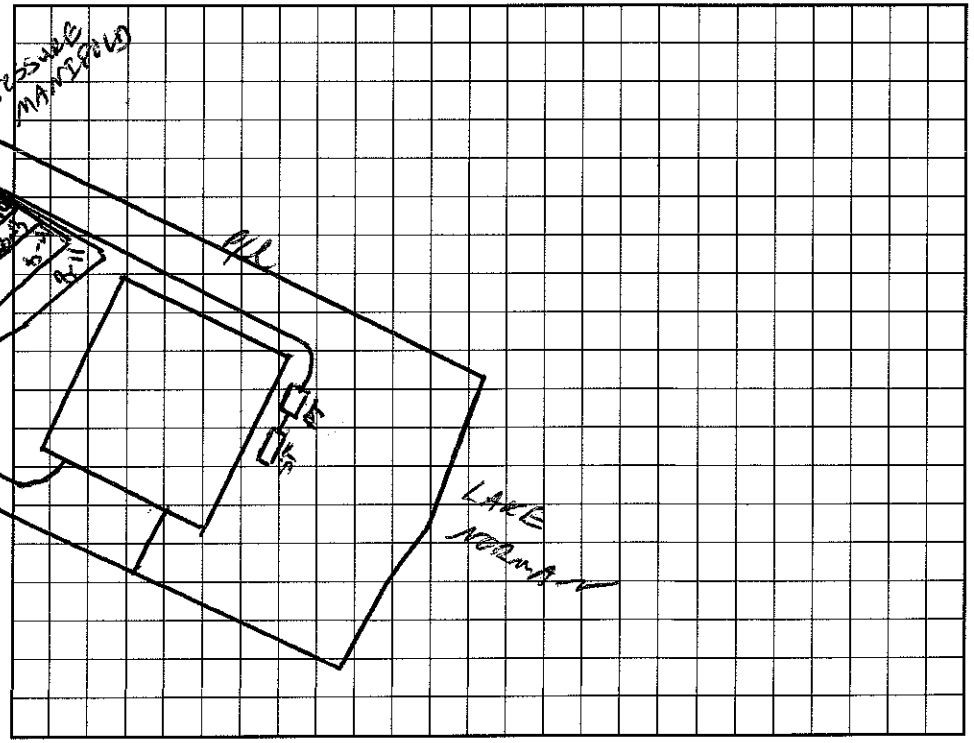

I understand that this permit can be suspended or revoked if any false information is supplied toward securing the permit/any unauthorized changes are made to the site/any unauthorized changes are made in the installation of the system. Improvement Permit with plat valid without expiration. Improvement Permit with site plan valid for sixty months. Authorization to Construct is valid for a period equal to that of Improvement Permit – not to exceed sixty months.

Signed: date

Improvement Permit by: C. Gary Long date 4/13/98

Authorization to Construct by: C. [illegible] date 4/13/98

Installed by: MacLeod Const. Co.

Operation Permit by: Wesley Sparks RS. date 10/30/98

Existing System Inspection by: date

HEALTH DEPT. COPY: WHITE INSPECTION COPY (FINAL): GREEN OWNER COPY (FINAL): YELLOW INSPECTION COPY (INITIAL): PINK OWNER COPY (INITIAL): GOLD