Authorization to Construct

IREDELL COUNTY HEALTH DEPARTMENT

STATESVILLE 704-878-5305 MOORESVILLE 704-664-5281

IMPROVEMENT PERMIT / ~~CERTIFICATE OF COMPLETION~~ / OPERATION PERMIT / EXISTING SYSTEM INSPECTION

PROPERTY DESCRIPTION NO. 18984 DATE Dec 10, 194 TAX MAP NO. part of 2CA3 Watershed: ☑ Yes ☐ No

OWNER OR CONTRACTOR Crescent Resources, LLC (Sawsy Burbank) PHONE: Business ~~Home~~ 4625-49-7988 WSII

ADDRESS PO Box 1003 Charlotte

LOCATION 1100 TR Bay Harbour Rd. 2nd on left past Beach Area Ct.

SUBDIVISION The Harbour BLOCK / SECTION 6 1 LOT 72 LOT AREA 20,000 SF± SITE CLASS. 5 per 1956 DESIGN FLOW 360 gpd L.T.A.R. .03

Septic Tank: 1000 Gallons; STB 794 Date 8/5/96
Pump Tank: ____ Gallons; PT ____ Date ____
Pump Make: ____ Model ____ Serial No. ____
Nitrification Field: No Fields 1 Square Feet ____ Linear Feet 267'
No Lines 3 4 Trench Width 24" Max Trench Bottom Depth 30" Gravel Depth N/A

☑ New System ☐ Repair System Type: I, II, III, IV, V, VI
System Description: gravity PTBRS
Repair System Description: Rpr/Lp PTBRS
Maintenance Agreement Required: ☐ Yes ☑ No


☑ House/Mod. Home No. Bedrooms 3
☐ Mobile Home No. Bathrooms 3
☐ Business No. Employees ____
☐ Other ____
☐ Slab ☑ Crawl Space ☐ Basement w/plumbing ☐ Basement wo/plumbing

Water Supply:
☐ Individual
☑ Community
☐ Public


Comments:

Comments: ~~PROPER~~ Authorization To Construct ~~PERMIT~~ 4.1.96 kms

INITIAL SITE SKETCH

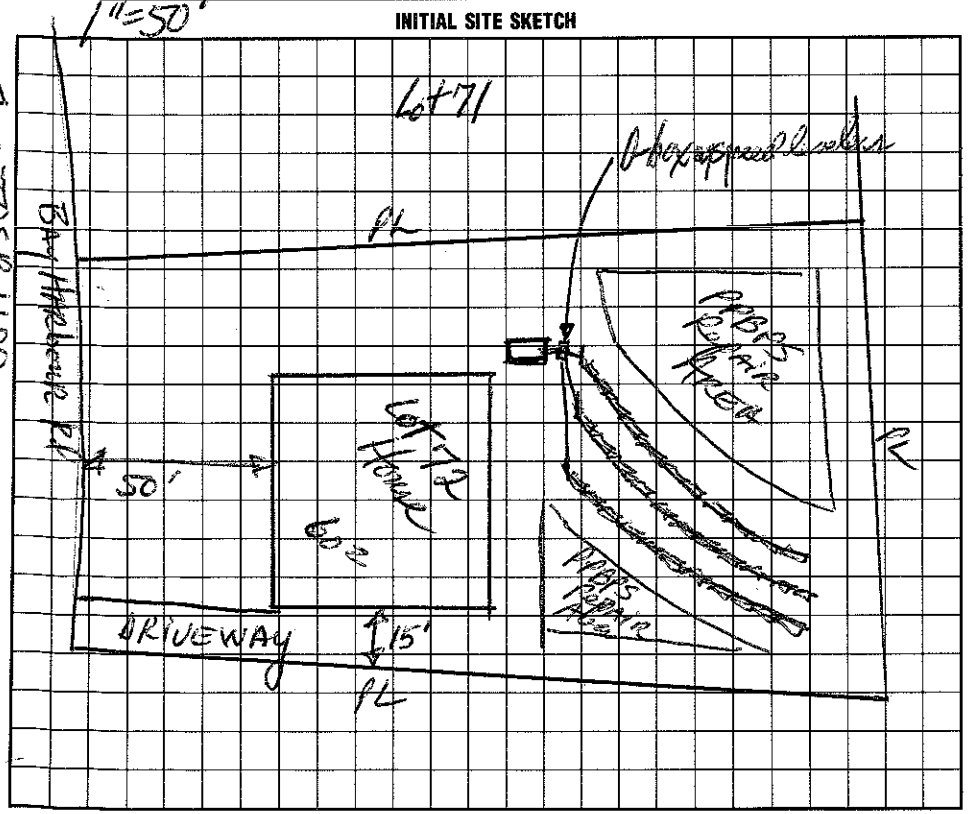

AS BUILT SKETCH

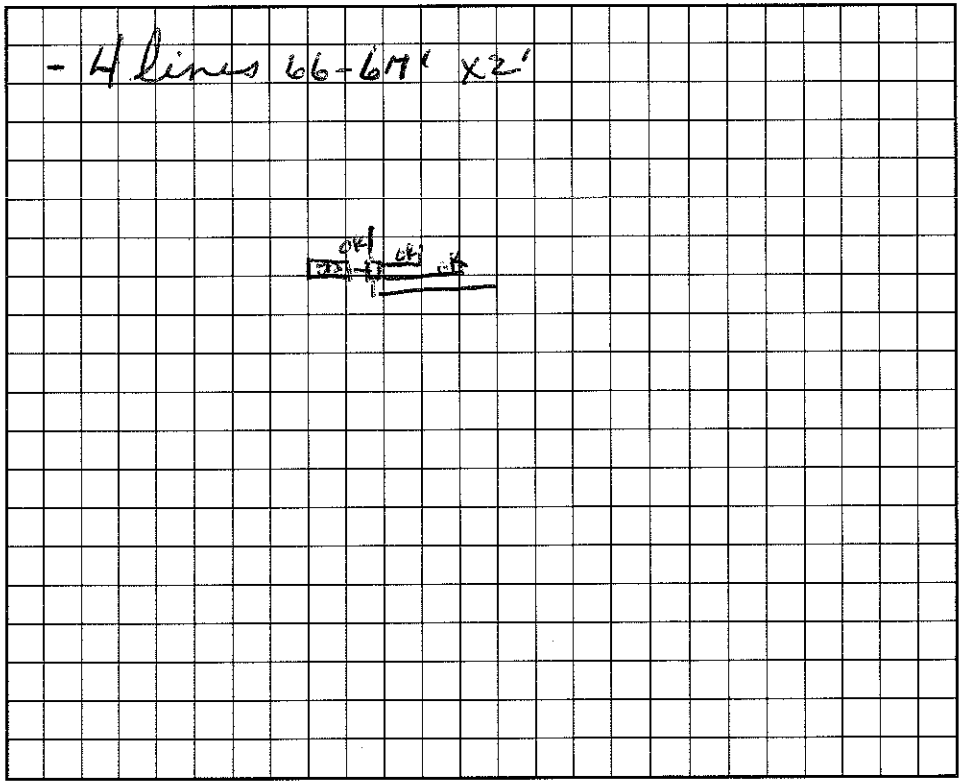

4 - TOSR1100

I understand that this permit can be suspended or revoked if any false information is supplied toward securing the permit/any unauthorized changes are made to the site/any unauthorized changes are made in the installation of the system. Improvement Permit is valid for 60 months from date of issuance.

Signed: ____

Improvement Permit by: Authorization to Construct: Wesley Sparks RS date 12/10/94

Existing System Inspection by: Wesley Sparks RS date 4/1/96

Installed by: Bay Thompson

Certificate of Completion by: ____ date ____

Operation Permit by: Wesley Sparks RS date 10/14/96

HEALTH DEPT. COPY: WHITE INSPECTION COPY (FINAL): GREEN OWNER COPY (FINAL): YELLOW INSPECTION COPY (INITIAL): PINK OWNER COPY (INITIAL): GOLD