IREDELL COUNTY HEALTH DEPARTMENT

AUTHORIZATION TO CONSTRUCT

STATESVILLE 704-878-5305 MOORESVILLE 704-664-5281

IMPROVEMENT PERMIT / ~~CERTIFICATE OF COMPLETION~~ / OPERATION PERMIT / EXISTING SYSTEM INSPECTION

PROPERTY DESCRIPTION NO. 22243 DATE 10/4/95 TAX MAP NO. 2F 12 A 70 Watershed: ☒ Yes ☐ No

OWNER OR CONTRACTOR Sunny Burbank PHONE: Business 896-0568 ~~Home~~ 4625-49-9803

ADDRESS PO Box 176 Davidson, NC. 28036

LOCATION 1100 Th Bay Harbour TL Beach Fern to cul de sac, right of center between cul

SUBDIVISION The Harbour BLOCK / SECTION 1 LOT 70 LOT AREA .93 SITE CLASS. 0 PS DESIGN FLOW 480 L.T.A.R. .3

Septic Tank: 1000 Gallons; STB 825 Date 6/26/96

Pump Tank: _____ Gallons; PT _____ Date _____

Pump Make: _____ Model _____ Serial No. _____

Nitrification Field: No Fields 1 Square Feet 1600 Linear Feet 400

No Lines 4 Trench Width 36" Max Trench Bottom Depth 36" Gravel Depth N/A

☒ New System ☐ Repair System Type: I, II, ☒ III, IV, V, VI

System Description: Gravity - Infiltrator

Repair System Description: Gravity Panel

Maintenance Agreement Required: ☒ Yes ☐ No

☒ House/Mod. Home No. Bedrooms 4

☐ Mobile Home No. Bathrooms 3

☐ Business No. Employees ____

☐ Other ____

☐ Slab ☐ Crawl Space ☒ Basement w/plumbing ☐ Basement wo/plumbing


Water Supply: ☐ Individual ☒ Community ☐ Public

Comments: Lot enlarged some from original plat. Follow slope contour direction shown


Comments:

1" = 50'

INITIAL SITE SKETCH

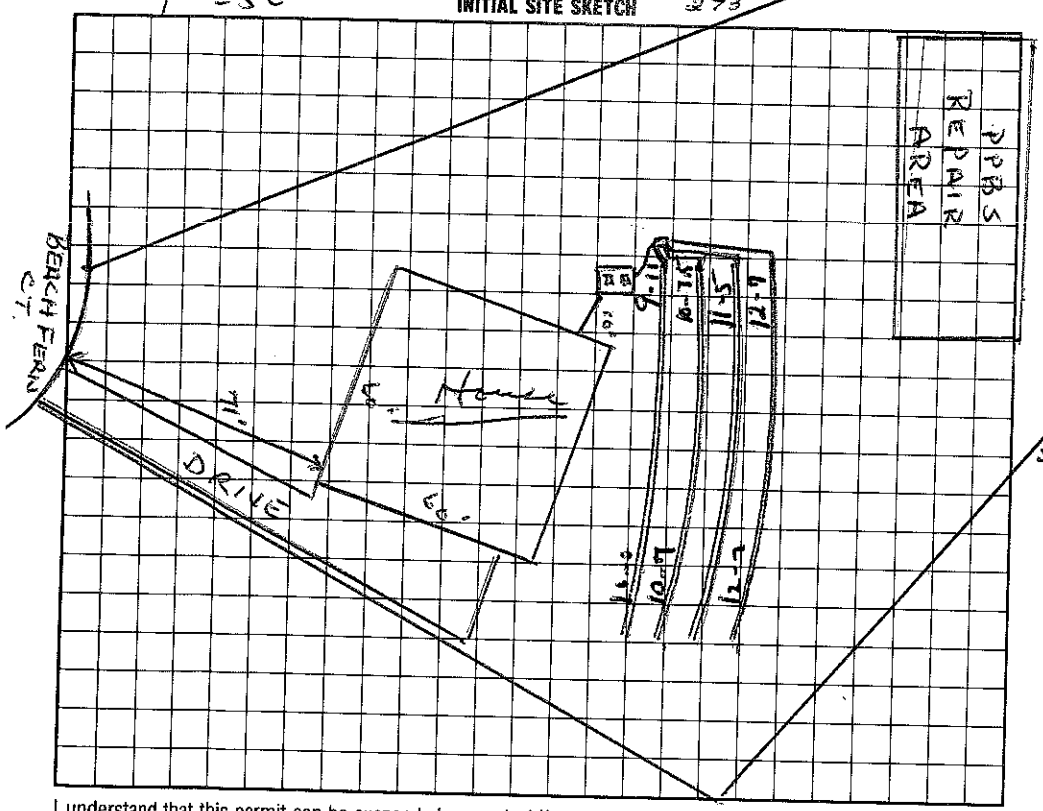

AS BUILT SKETCH

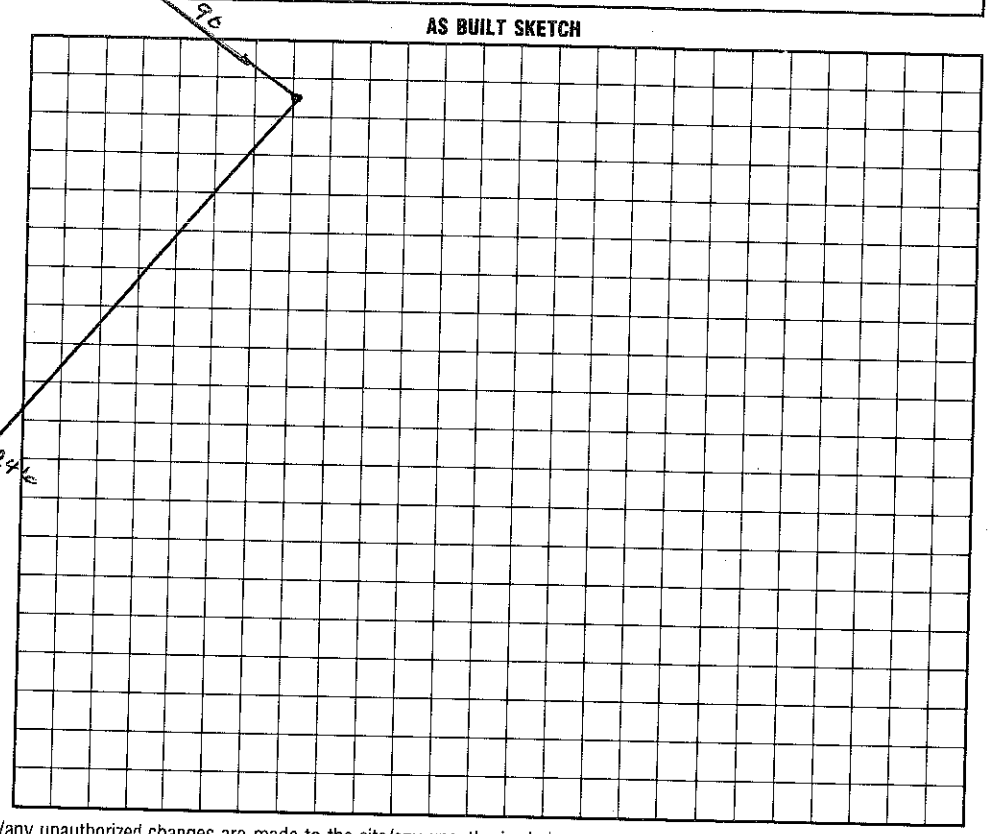

I understand that this permit can be suspended or revoked if any false information is supplied toward securing the permit/any unauthorized changes are made to the site/any unauthorized changes are made in the installation of the system.

AUTHORIZATION TO CONSTRUCT VALID 5 YEARS FROM ISSUE DATE. IMPROVEMENT PERMIT HAS NO TIME LIMIT.

Signed: _____

Improvement Permit by: Wesley Sparks RS. date 10/4/95

~~Certificate of Completion by:~~ _____ date _____

Existing System Inspection by: Wesley Sparks RS. date 10/4/95

Installed by: Ben Thompson

~~EXISTING SYSTEM BY:~~

Operation Permit by: Wesley Sparks RS. date 8/8/96

HEALTH DEPT. COPY: WHITE INSPECTION COPY (FINAL): GREEN OWNER COPY (FINAL): YELLOW INSPECTION COPY (INITIAL): PINK OWNER COPY (INITIAL): GOLD