IREDELL COUNTY HEALTH DEPARTMENT

STATESVILLE 704-878-5305 MOORESVILLE 704-664-5281

IMPROVEMENT PERMIT / AUTHORIZATION TO CONSTRUCT / OPERATION PERMIT / EXISTING SYSTEM INSPE

PERMIT# 101225 PIN# 4625941684 DATE

OWNER OR CONTRACTOR GM Helms PHONE: Business Home

ADDRESS

LOCATION Brawley School Rd TR Lightship Drive on right

SUBDIVISION The Point BLOCK / SECTION 8 LOT 824 LOT AREA SITE CLASS PS DESIGN FLOW 480 gpd L.T.A.R. .3

Septic Tank: 1500 Gallons: STB 338 Date 7-22-05
Pump Tank: 1000 Gallons: PT 283 Date 7-29-05
Pump Make: Model Serial No.
Nitrification Field: No. Fields 1 Square Feet 1200 Linear Feet 400
No Lines 4 @ 100' Trench Width 36" Max Trench Bottom Depth 36" Gravel Depth N/A

X New System ☐ Repair System Type: I, II, III, IV, V, VI
System Description: Pump-EZ Flow
Repair System Description:
Maintenance Agreement Required: ☐ Yes X No Not Initially


X House/Mod. Home No. Bedrooms 4
☐ Mobile Home No. Bathrooms 4
☐ Business No. Employees
☐ Other
☐ Slab ☐ Crawl Space X Basement w/plumbing ☐ Basement wo/plumbing

Water Supply:
☐ Individual
X Public
X Community


Comments:/Conditions: Installed 4 lines @ 100' ea EZ Flow

Scale 1:50

INITIAL SITE SKETCH

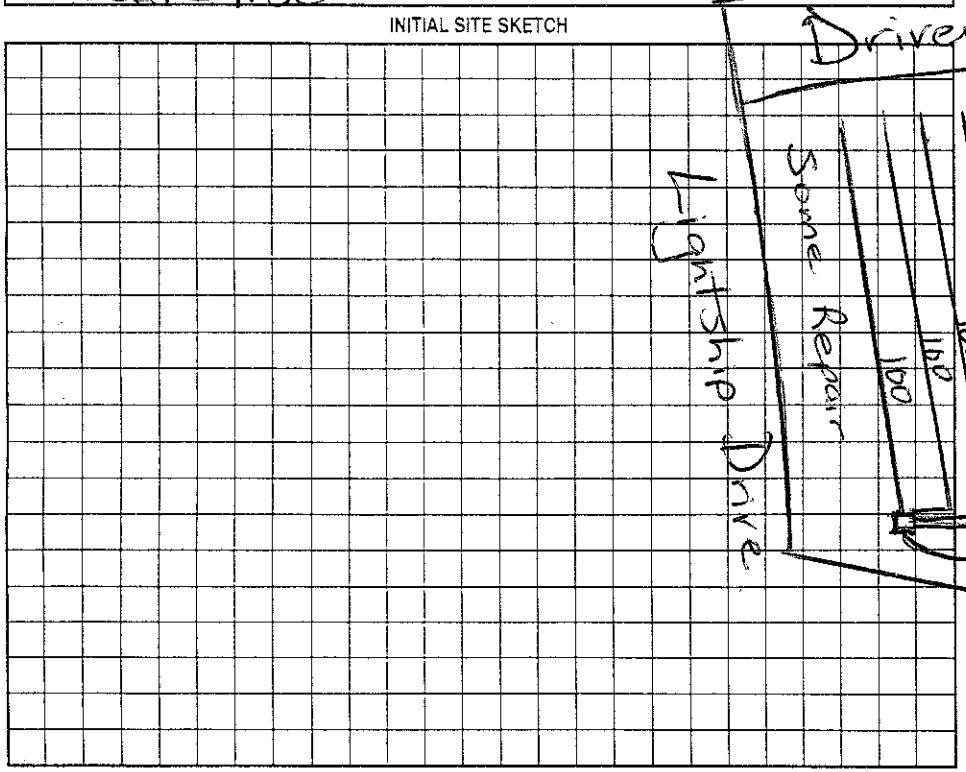

AS BUILT SKETCH

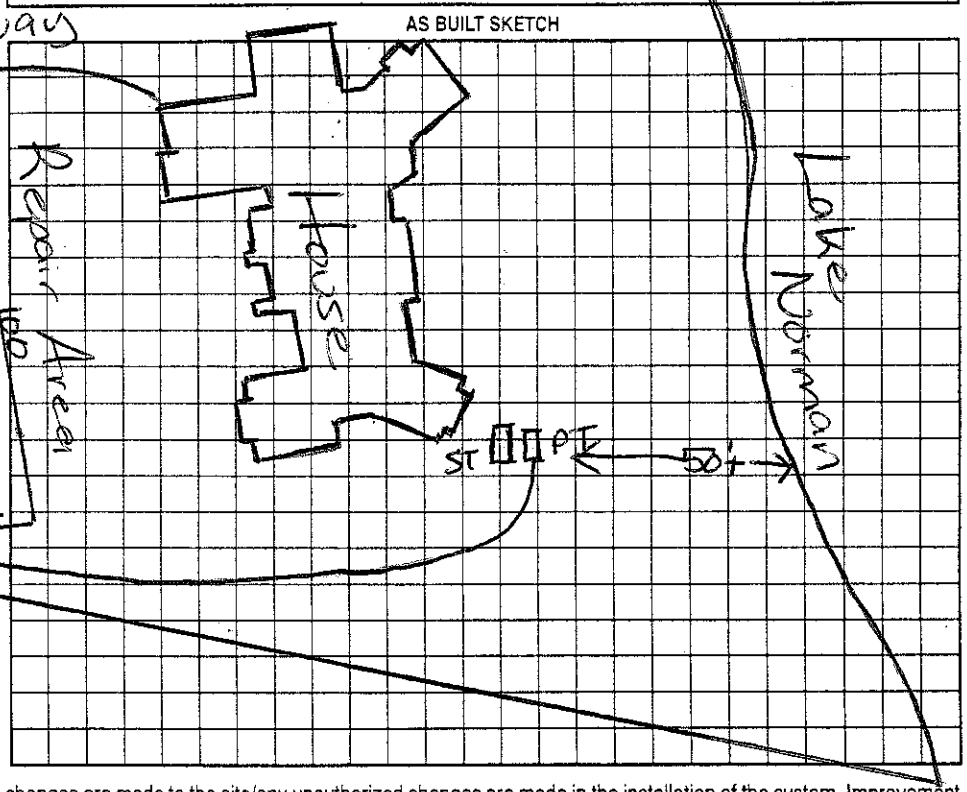

Permit can be suspended or revoked if any false information is supplied toward securing the permit/any unauthorized changes are made to the site/any unauthorized changes are made in the installation of the system. Improvement Permit with plat valid without expiration. Improvement Permit with site plan valid for sixty months. Authorization to Construct is valid for a period equal to that of Improvement Permit – not to exceed sixty months.

Signed: X [signature] date

Improvement Permit by: date

Authorization to Construct by: date

Installed by: R & H

Operation Permit by: [signature] PS date 11/9/05

Existing System Inspection by: date

HEALTH DEPT. COPY: WHITE OWNER COPY (FINAL): YELLOW OWNER COPY (INITIAL): PINK