IREDELL COUNTY HEALTH DEPARTMENT

STATESVILLE 704-878-5305 MOORESVILLE 704-664-5281

IMPROVEMENT PERMIT / AUTHORIZATION TO CONSTRUCT / OPERATION PERMIT / EXISTING SYSTEM INSPECTION

PERMIT# 101264 PIN# 4625 94 1684 .858 4625.501157 DATE Oct 9, 01

OWNER OR CONTRACTOR Crescent Resources Inc. - KINGSWOOD Home/Business Home

ADDRESS P.O. Box 1003 Charlotte N.C. 28201

LOCATION Brawley Sch RD. TR Lightship DRIVE TR Swayne St. 2nd lt on Right

SUBDIVISION The Point BLOCK / SECTION 8 LOT 858 LOT AREA 36,440 ft² SITE CLASS. PS DESIGN FLOW 480 gpd L.T.A.R. .3 initial/.25 Repair

Septic Tank: 1000 Gallons; STB 338 Date 2/7/05

Pump Tank: 1000 Gallons; PT 283 Date 2/10/05

Pump Make: Goulds Model WE0512MA Serial No. B05338784

Nitrification Field: No Fields 1 Square Feet 1200 Linear Feet 400

No Lines 4@100' Trench Width 36" Max Trench Bottom Depth 36" Gravel Depth NA

☑ New System ☐ Repair System Type: I, II, III, IV, V, VI

System Description: PM - INNOVATIVE - 25% Red

Repair System Description: LP PBBPS

Maintenance Agreement Required: ☐ Yes ☑ No initially

☐ Slab ☑ Crawl Space ☐ Basement w/plumbing ☐ Basement wo/plumbing

☑ House/Mod. Home No. Bedrooms 4

☐ Mobile Home No. Bathrooms 4

☐ Business No. Employees


☐ Other

Water Supply: ☐ Individual ☑ ~~Public~~ ☑ Community


Comments:/Conditions:

Comments:/Conditions:

INITIAL SITE SKETCH 1" = 50'

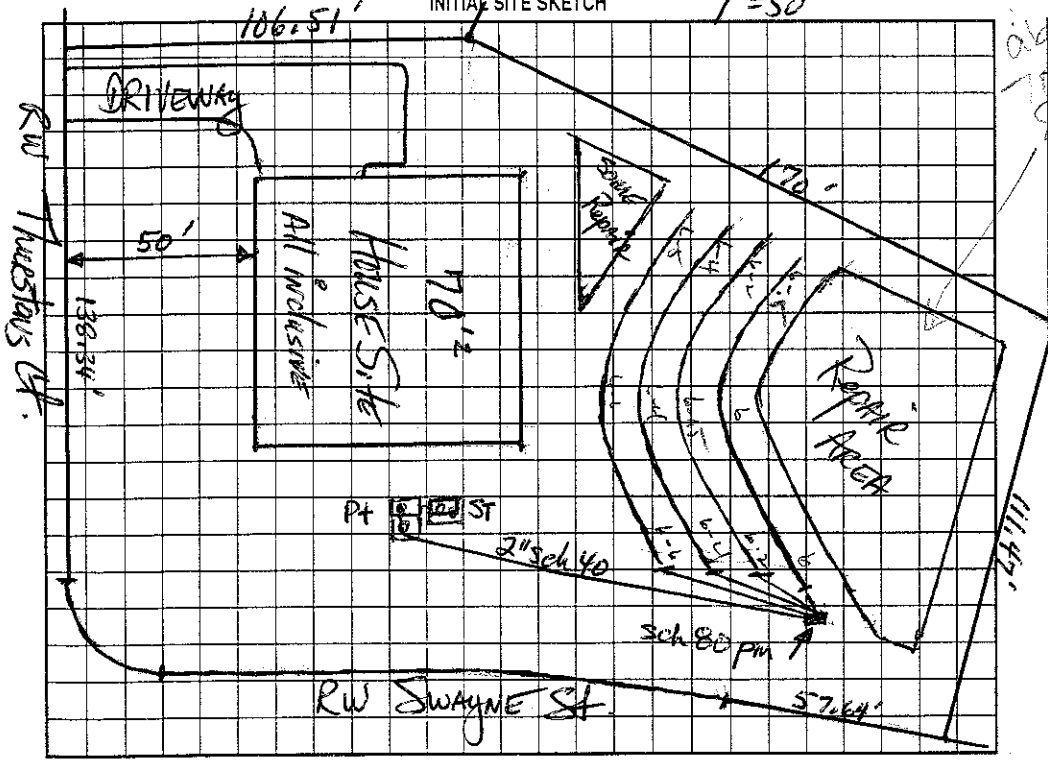

AS BUILT SKETCH

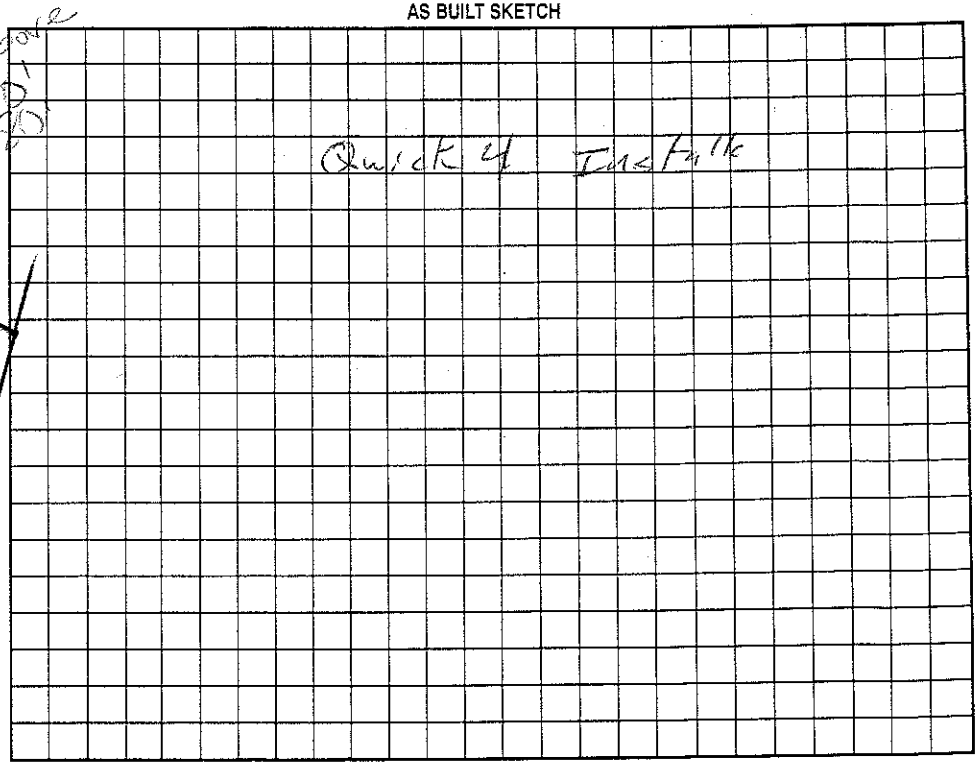

Permit can be suspended or revoked if any false information is supplied toward securing the permit/any unauthorized changes are made to the site/any unauthorized changes are made in the installation of the system. Improvement Permit with plat valid without expiration. Improvement Permit with site plan valid for sixty months. Authorization to Construct is valid for a period equal to that of Improvement Permit – not to exceed sixty months.

Signed: date 10/10/01 Installed by:

Improvement Permit by: David Robinson P.E. date 10-9-01 Operation Permit by: Wesley Sparks RS date

Authorization to Construct by: Wesley Sparks RS. date 9/24/04 Existing System Inspection by: date

HEALTH DEPT. COPY: WHITE OWNER COPY (FINAL): YELLOW OWNER COPY (INITIAL): PINK