IREDELL COUNTY HEALTH DEPARTMENT

STATESVILLE 704-878-5305 MOORESVILLE 704-664-5281

IMPROVEMENT PERMIT / AUTHORIZATION TO CONSTRUCT / OPERATION PERMIT / EXISTING SYSTEM INSPECTION

PERMIT# ~~101263~~ 101262 PIN# ~~4625 94 1684.856~~ 4625-50-1304 DATE October 8, 01

OWNER OR CONTRACTOR Crescent Resources Clive/Lt Norman Signature PHONE ~~Business~~ Home

ADDRESS P.O. Box 1003 Charlotte NC 28201

LOCATION Brawley Sch Rd. TR Lightship DR. 4th lot on left

SUBDIVISION The Point BLOCK / SECTION 8 LOT 856 LOT AREA 32,698 ft² SITE CLASS. PS DESIGN FLOW ~~480~~ gpd L.T.A.R. w.25

Septic Tank: ~~1000~~ 1500 Gallons; STB 333 Date 4/22/06

Pump Tank: 1000 Gallons; PT 2 Date 5/28/06

Pump Make Geotech Model VE6 p 12 HH Serial No. 405669/0

Nitrification Field: No Fields 1 Square Feet 640/960 Linear Feet 320

No Lines 4@80' Trench Width 24" min 36" Max Trench Bottom Depth 36" Gravel Depth NA

☑ New System ☐ Repair System Type: I, II, III, ⓘ V, VI

System Description: CPPBS

Repair System Description: SAME

Maintenance Agreement Required: ☑ Yes ☐ No

☐ ~~House~~/Mod. Home No. Bedrooms 4

☐ Mobile Home No. Bathrooms 4

☐ Business No. Employees

☐ Other

☐ Slab ☑ Crawl Space ☐ Basement w/plumbing ☐ Basement wo/plumbing

Water Supply: ☐ Individual ☐ ~~Public~~ ☑ Community


Comments/Conditions: OR 36" max 9'oc

Note: No room for pool in backyard!

Comments/Conditions: 8/16/05 Reviewed Building plans & site plan; essentially in Compliance with I.P. Note: Tanks will have to be moved to behind house

1"=50'

INITIAL SITE SKETCH

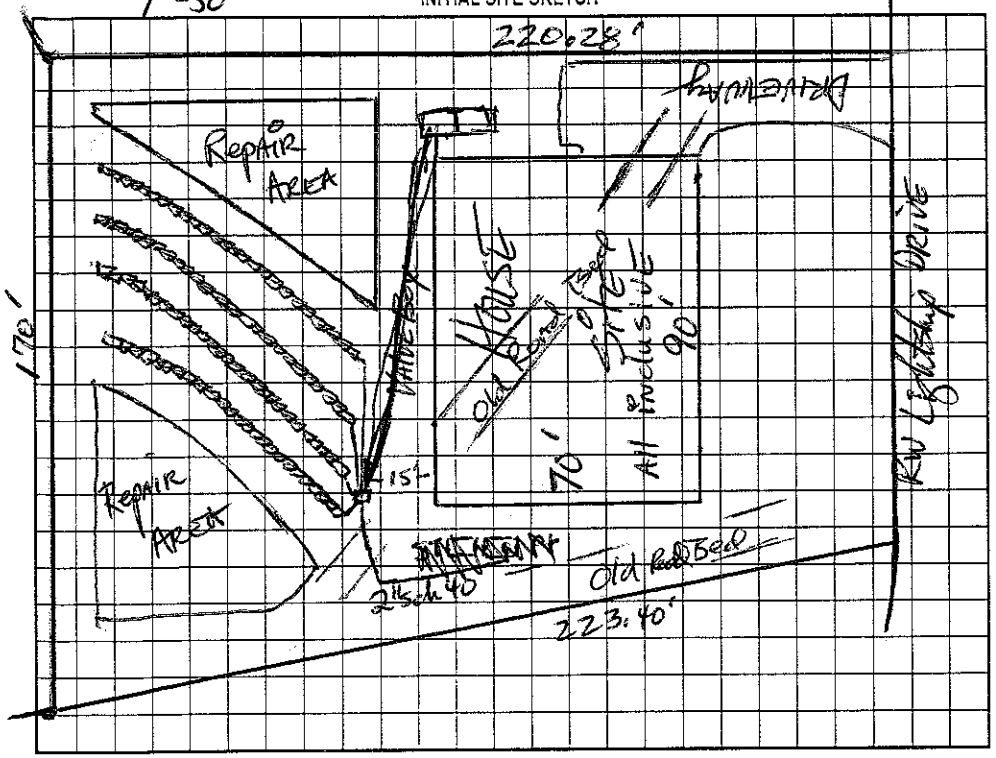

AS BUILT SKETCH

Permit can be suspended or revoked if any false information is supplied toward securing the permit/any unauthorized changes are made to the site/any unauthorized changes are made in the installation of the system. Improvement Permit with plat valid without expiration. Improvement Permit with site plan valid for sixty months. Authorization to Construct is valid for a period equal to that of Improvement Permit – not to exceed sixty months.

Signed: date 10/10/01

Improvement Permit by: date 10-8-01

Authorization to Construct by: date 8/16/05

Installed by: Hallman

Operation Permit by: Wesley Sparks RS date 7/26/06

Existing System Inspection by: date

HEALTH DEPT. COPY: WHITE OWNER COPY (FINAL): YELLOW OWNER COPY (INITIAL): PINK