IREDELL COUNTY HEALTH DEPARTMENT

STATESVILLE 704-878-5305 MOORESVILLE 704-664-5281

IMPROVEMENT PERMIT / AUTHORIZATION TO CONSTRUCT / OPERATION PERMIT / EXISTING SYSTEM INSPECTION

3:00

PERMIT# 10223111466 PIN# ~~4625941684822~~ 4625-50-2730 DATE 7-11-03

OWNER OR CONTRACTOR Tom Stevenson Builders/Anderson PHONE: Business 660-6638 Home

ADDRESS 631 Brawley School Rd Ste 503 Mooresville, NC 28117

LOCATION Brawley School Rd TR Lightship On right

SUBDIVISION The Point BLOCK / SECTION 8 LOT 822 LOT AREA 46,434 ft² SITE CLASS. PS DESIGN FLOW 480gpd L.T.A.R. .25

Septic Tank: 1600+ Gallons; STB 338 Date 8-8-03

Pump Tank: 1000 Gallons; PT 27 Date 8-8-03

Pump Make: Myers Model ME50S-21 Serial No.

Nitrification Field: No Fields 1 Square Feet 960 Linear Feet 320+

No Lines 4 Trench Width 24"-36" Max Trench Bottom Depth 36" Gravel Depth N/A

☒ New System ☐ Repair System Type: I, II, III, ⓘ, V, VI

System Description: Pump-LP-Panel Block

Repair System Description: Same

Maintenance Agreement Required: ☒ Yes ☐ No

☒ House/Mod. Home ☐ Mobile Home ☐ Business ☐ Other

No. Bedrooms 4 No. Bathrooms No. Employees

☐ Slab ☐ Crawl Space ☒ Basement w/plumbing ☐ Basement wo/plumbing


Water Supply: ☐ Individual ☒ Public ☒ Community

Comments/Conditions: Keep Septic System at least 10' from PL 50' from lake & drainfield at least 25' from basement wall. Very tight site!


Comments/Conditions: 3/16" hole 70 panels total Bluefilter installed Checked tanks & lines 9/11/03

INITIAL SITE SKETCH

Scale 1:50

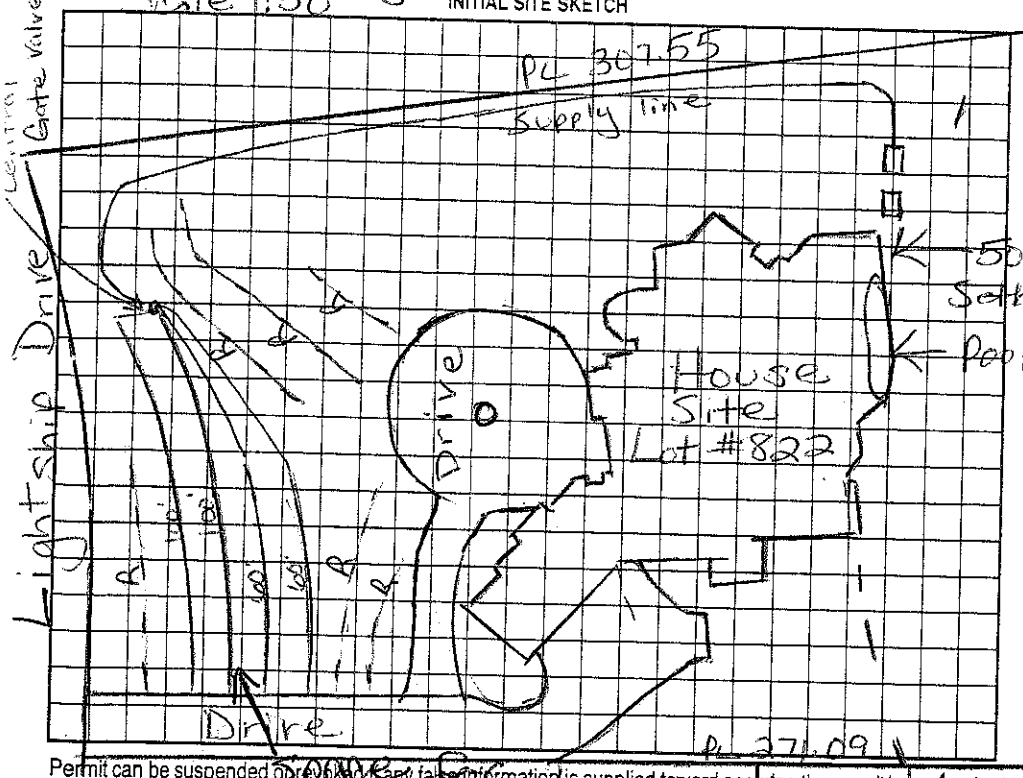

AS BUILT SKETCH

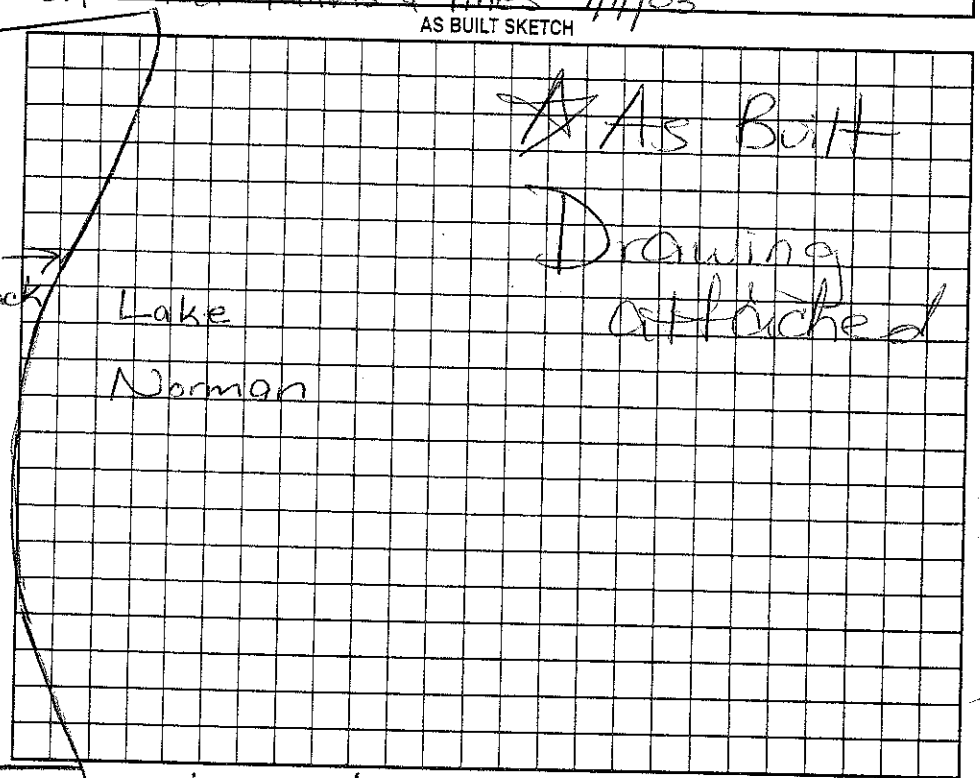

Permit can be suspended or revoked if any false information is supplied toward securing the permit/any unauthorized changes are made to the site/any unauthorized changes are made in the installation of the system. Improvement Permit with plat valid without expiration. Improvement Permit with site plan valid for sixty months. Authorization to Construct is valid for a period equal to that of Improvement Permit – not to exceed sixty months.

Signed: [signature] date

Improvement Permit by: Maria H. Dotson RS date 7/14/03

Authorization to Construct by: Maria H. Dotson RS date 7/14/03

Installed by: [signature]

Operation Permit by: Maria H. Dotson RS date 11/12/03

Existing System Inspection by: date

HEALTH DEPT. COPY: WHITE OWNER COPY (FINAL): YELLOW OWNER COPY (INITIAL): PINK