IREDELL COUNTY HEALTH DEPARTMENT - *ENVIRONMENTAL HEALTH* ☐ STATESVILLE OFFICE 704-878-5305 ☐ MOORESVILLE OFFICE 704-664-5281

IMPROVEMENT PERMIT / AUTHORIZATION TO CONSTRUCT / OPERATION PERMIT / EXISTING SYSTEM INSPECTION

PERMIT # 169951 PIN # 4625505104 DATE 1-12-2012

OWNER Kenneth Beagler APPLICANT: Same PHONE: Home/Cell # 7043638900 Business # 7046626400

SITE ADDRESS P.O. Box 3398 Mooresville, NC 28166 OWNER / APPLICANT ADDRESS Same

SITE DIRECTIONS Brawley School Rd TR Lightship TL Swayne Dr. on left

SUBDIVISION The Point BLOCK / SECTION LOT # 852 LOT AREA .83 Ac DESIGN FLOW 480 gpd L.T.A.R. .3

Existing

Septic Tank 1000 Gallons: STB 794 Date 1/10/98

Pump Tank Gallons: P T Date

Pump Make Model Serial #

No. Nitrification Fields: 1 No. Lines 5 Linear Feet 400'

Existing Trench Width 36" Max. Trench Bottom Depth 36" Gravel Depth N/A

☐ New System ☐ Repair ☐ Expansion System Type I (II) III IV V VI

System Description: Existing Gravity - 25% Reduction

Repair System Description: Pump - LPPPBPS

Maintenance Agreement Required ☐ YES ☒ NO

☒ GRAVITY ☐ PRESSURE

☒ Residence No. Bedrooms 4

☐ Business No. Persons

☐ Other No. Employees

☐ Slab ☐ Crawl Space

☐ Basement w/plumbing ☐ Basement w/o plumbing


Water Supply: ☐ Private ☐ Public ☐ Community

Comments / Conditions: Existing Septic System Appears to be Functioning Okay at time of inspection. Must keep house at least 5FT from Septic System

Any future swimming pool must be 15FT from Septic System.

★ Well abandonment record attached.

INITIAL SITE SKETCH

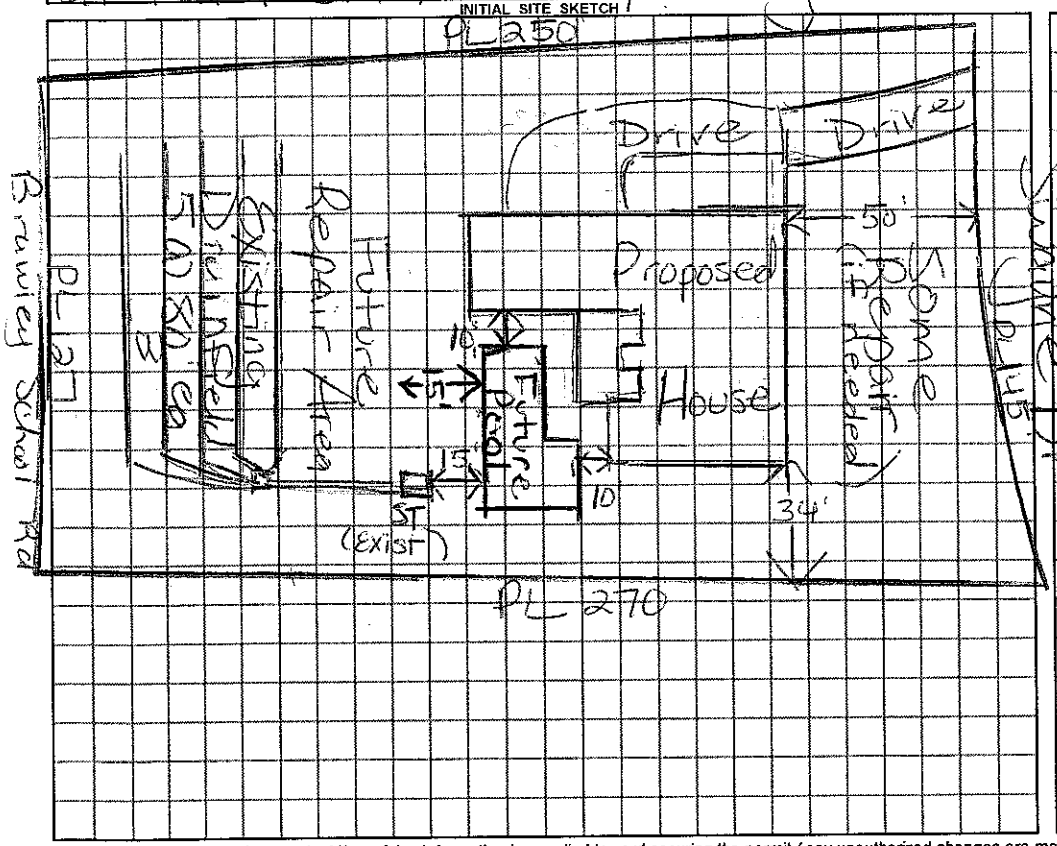

AS BUILT SKETCH

Permit can be suspended or revoked if any false information is supplied toward securing the permit / any unauthorized changes are made to the site / any unauthorized changes are made in the installation of the system.

☐ ***IMPROVEMENT PERMIT*** with plat valid without expiration ☐ ***IMPROVEMENT PERMIT*** with plat ~~valid without expiration~~ site plan valid 60 mo. ☐ ***AUTHORIZATION TO CONSTRUCT*** valid for period equal to IMPROVEMENT PERMIT--no

Owner / Applicant Signature: [signature] Date 1/13/12

IMPROVEMENT PERMIT by: REHS Date

AUTHORIZATION TO CONSTRUCT by: REHS Date

Installed by: Bobby Mayhew 3/3/9[illegible]

OPERATION PERMIT by: REHS

Existing System Inspected by: [signature] REHS

YOU SHOULD CONTACT A LOCATOR SERVICE PRIOR TO ANY EXCAVATION

White Copy – Environmental Health YELLOW COPY (Final) Owner / Applicant PINK COF