IREDELL COUNTY HEALTH DEPARTMENT

STATESVILLE 704-878-5305 500 Paid MOORESVILLE 704-[illegible]-5281

IMPROVEMENT PERMIT / AUTHORIZATION TO CONSTRUCT / OPERATION PERMIT / EXISTING SYSTEM INSPECTION

PERMIT# 101218 PIN# 4625-94-1684.819 4625506693 DATE 11/17/03

OWNER OR CONTRACTOR Simonini Builders PHONE: Business _____ Home _____

ADDRESS PO Box 1003 Charlotte NC

LOCATION BSR, TR Lightship, 3rd on Rt.

SUBDIVISION Point BLOCK / SECTION 6 LOT 819 LOT AREA 45,844 ft² SITE CLASS. PS DESIGN FLOW 480 L.T.A.R. 0.25

Septic Tank: ~~1000~~ 1500 Gallons; STB 233 Date 10/15/03
Pump Tank: 1000 Gallons; PT 283 Date 9/10/03
Pump Make: Myers Model ME50 Serial No. _____
Nitrification Field: No Fields 1 Square Feet 1500 Linear Feet 500
No Lines 5@100' Trench Width 36" Max Trench Bottom Depth 36" Gravel Depth —

☒ New System ☐ Repair System Type: I, II, III, IV, V, VI
System Description: PM - 25% Reduction
Repair System Description: LP Panel Block
Maintenance Agreement Required: ☐ Yes ☒ No

☒ House/Mod. Home ☐ Mobile Home ☐ Business ☐ Other
No. Bedrooms 4 No. Bathrooms 4 No. Employees _____


☐ Slab ☐ Crawl Space ☒ Basement w/plumbing ☐ Basement wo/plumbing

Water Supply: ☐ Individual ☐ Public ☒ Community


Comments:/Conditions:

Comments:/Conditions:

INITIAL SITE SKETCH

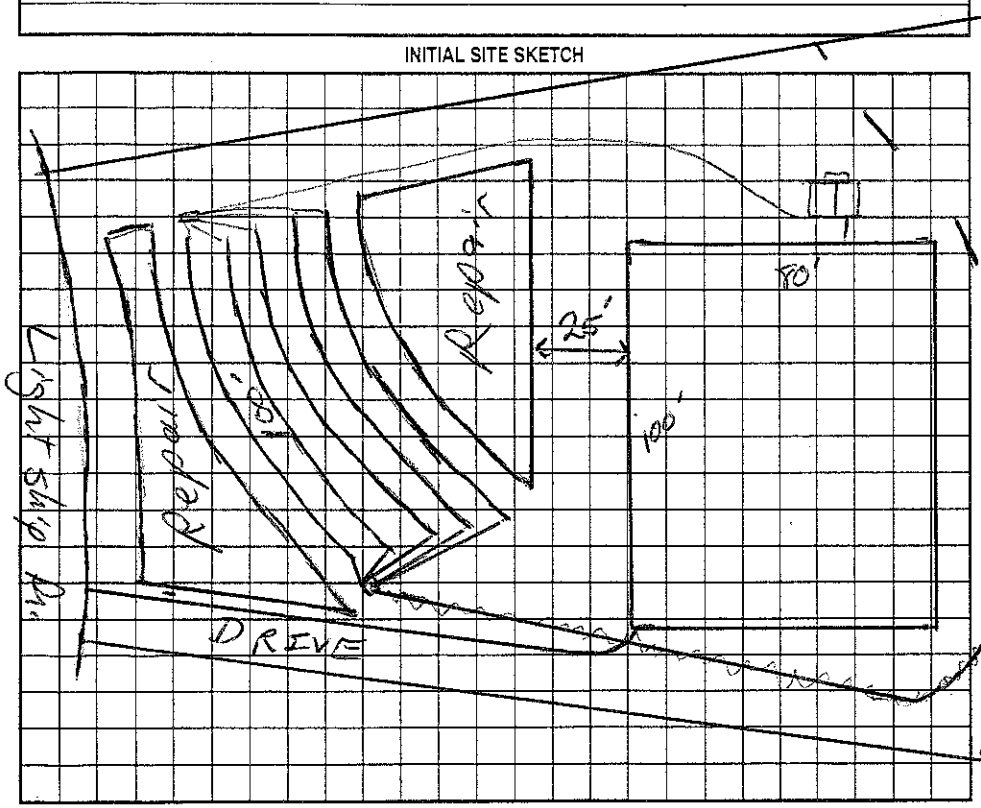

AS BUILT SKETCH

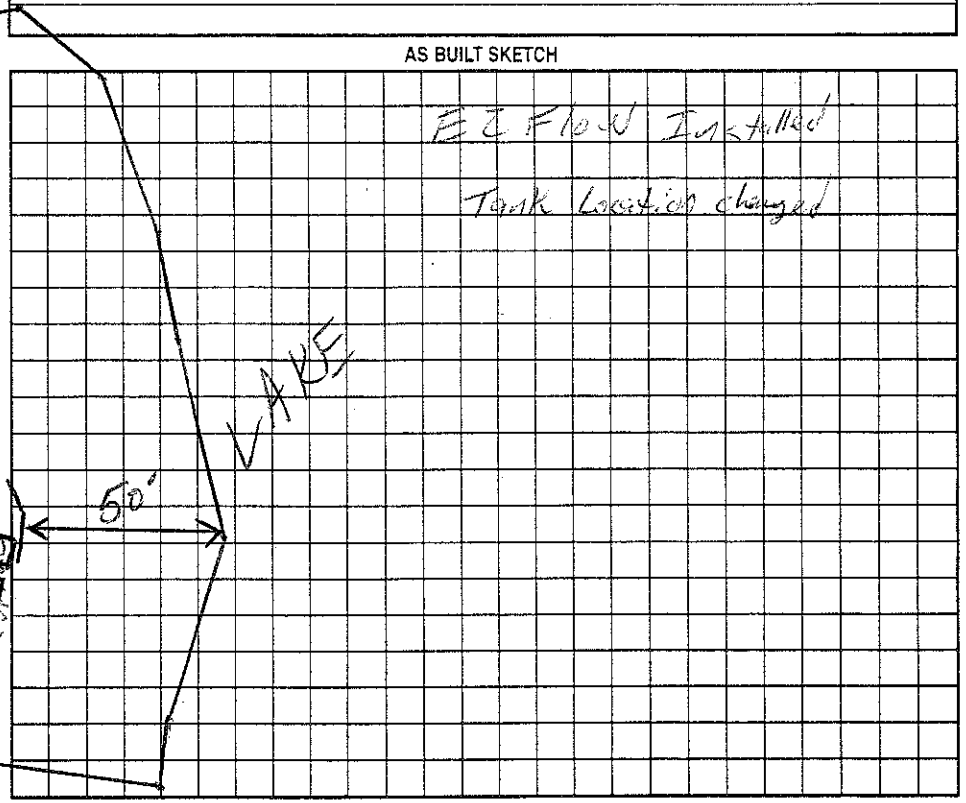

Permit can be suspended or revoked if any false information is supplied toward securing the permit/any unauthorized changes are made to the site/any unauthorized changes are made in the installation of the system. Improvement Permit with plat valid without expiration. Improvement Permit with site plan valid for sixty months. Authorization to Construct is valid for a period equal to that of Improvement Permit – not to exceed sixty months.

Signed: _____ date 11/20/03 Installed by: R + H

Improvement Permit by: RS date 11/17/03 Operation Permit by: _____ date 1/8/04

Authorization to Construct by: RS date 11/17/03 Existing System Inspection by: _____ date _____

HEALTH DEPT. COPY: WHITE OWNER COPY (FINAL): YELLOW OWNER COPY (INITIAL): PINK