IREDELL COUNTY HEALTH DEPARTMENT

STATESVILLE 704-878-5305 245.00 Paid MOORESVILLE 704-664-5281

IMPROVEMENT PERMIT / AUTHORIZATION TO CONSTRUCT / OPERATION PERMIT / EXISTING SYSTEM INSPECTION

PERMIT# 102176 / 19425 PIN# ~~4625-94-1648.853~~ 4625-50-7214 DATE 3/1/04

OWNER OR CONTRACTOR Kenneth Beaver Homes PHONE: Business 704-662-6400 Home

ADDRESS Po Box 3398 Mooresville, NC. 28117

LOCATION Brawley Sch Rd, TR Lightship Dr. 1st lot on (L)

SUBDIVISION Point BLOCK / SECTION 8 LOT 853 LOT AREA 40,146 SITE CLASS. PS DESIGN FLOW 480 L.T.A.R. .25

Septic Tank: 1500 Gallons; STB 338 Date 4/13/04
Pump Tank: 1500 Gallons; PT 421 Date 6/25/04
Pump Make: Gould's Model WE0512 1HP Serial No. D04859L
Nitrification Field: No Fields ___ Square Feet 640/960 Linear Feet 320
No Lines 4 @ 80' Trench Width 2 - 3' Max Trench Bottom Depth 3'

[X] New System [ ] Repair System Type: I, II, III, (IV) V, VI
System Description: Pressed 16" PPBPS
Repair System Description: Same Type
Maintenance Agreement Required: [X] Yes [ ] No

[X] House/Mod. Home No. Bedrooms 4
[ ] Mobile Home No. Bathrooms 4
[ ] Business No. Employees ___
[ ] Other

Gravel Depth N/A [ ] Slab [X] Crawl Space [ ] Basement w/plumbing [ ] Basement wo/plumbing


Water Supply: [ ] Individual [ ] Public [X] Community POINT

Comments:/Conditions: 2' on 8' Centers - 3' on 9' Centers.
1 - 3/16" hole per panel turned up near center of each panel


Comments:/Conditions: 16" Prefab. Panel Blocks
3/16" holes

1" = 50'

INITIAL SITE SKETCH

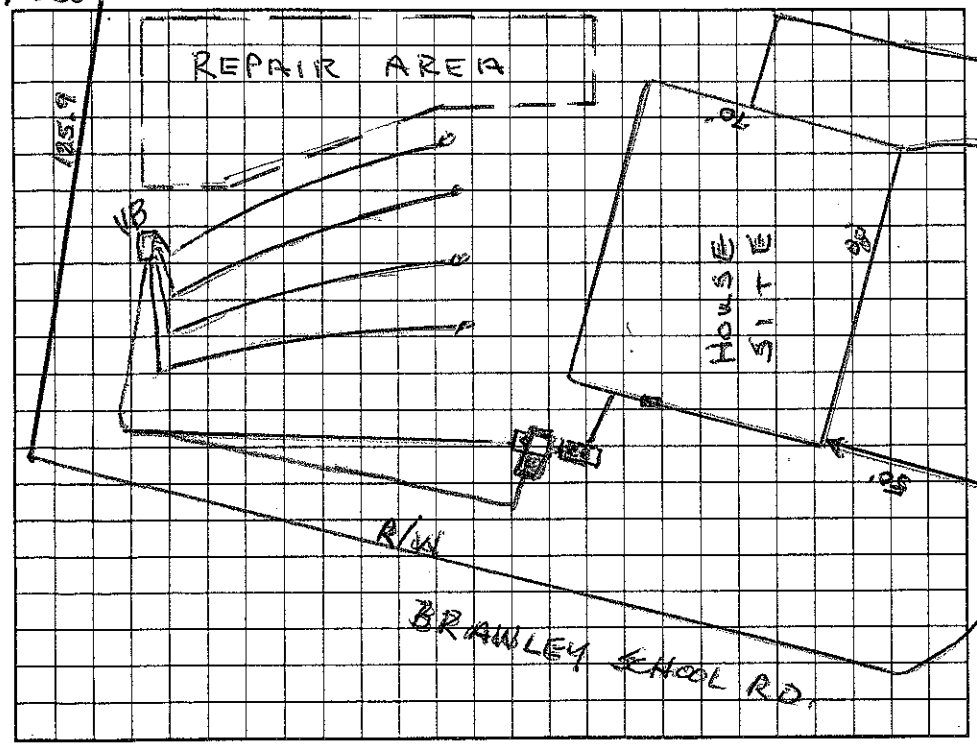

AS BUILT SKETCH

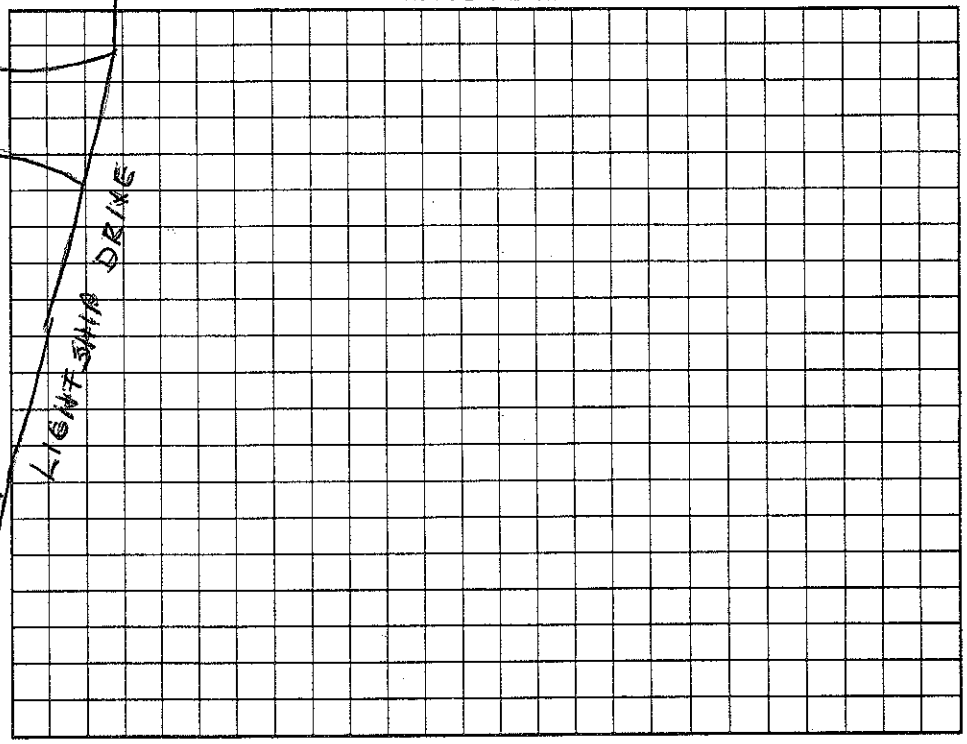

Permit can be suspended or revoked if any false information is supplied toward securing the permit/any unauthorized changes are made to the site/any unauthorized changes are made in the installation of the system. Improvement Permit with plat valid without expiration. Improvement Permit with site plan valid for sixty months. Authorization to Construct is valid for a period equal to that of Improvement Permit – not to exceed sixty months.

Signed: * Ken Chenault date 3/2/04 Installed by: Steve Jordan

Improvement Permit by: Wesley Sparks R.S. date 3/1/04 Operation Permit by: Wesley Sparks RS date 10/19/04

Authorization to Construct by: Wesley Sparks R.S. date 3/1/04 Existing System Inspection by: ___ date ___

HEALTH DEPT. COPY: WHITE OWNER COPY (FINAL): YELLOW OWNER COPY (INITIAL): PINK