IREDELL COUNTY HEALTH DEPARTMENT

STATESVILLE 704-878-5305 MOORESVILLE 704-664-5281

IMPROVEMENT PERMIT / AUTHORIZATION TO CONSTRUCT / OPERATION PERMIT / EXISTING SYSTEM INSPECTION

PERMIT# 101216 / 125451 PIN# 4625-94-1684.817 4625509463 DATE Sept. 28, 01

OWNER OR CONTRACTOR Crescent Resources Inc. / Brookshire Const. PHONE: Business (704) 363-7901 Home

ADDRESS P.O. Box 1003 Charlotte N.C. 28201

LOCATION Brawley School Road TR Lightship 1st Lot on Right

SUBDIVISION The Point BLOCK / SECTION B LOT 817 LOT AREA 56779 ft² SITE CLASS. PS DESIGN FLOW 460 gpd L.T.A.R. .3

Septic Tank: 1800 Gallons; STB 338 Date 5/2/05
Pump Tank: 1000 Gallons; PT 283 Date 5/1/05
Pump Make: Cornell Model CWED-5HH Serial No. 5/16/05
Nitrification Field: No Fields 1 Square Feet 1605 Linear Feet 535
No Lines 5@107' Trench Width 36" Trench Bottom Depth 36" Gravel Depth 12"

☑ New System ☐ Repair System Type: I, II, III, IV, V, VI
System Description: PM - CONVENTIONAL
Repair System Description: PM - CONVENTIONAL / INNOVATIVE
Maintenance Agreement Required: ☐ Yes ☑ No

☑ House/Mod. Home No. Bedrooms 4
☐ Mobile Home No. Bathrooms 4
☐ Business No. Employees
☐ Other


☑ Slab ☑ Crawl Space ☑ Basement w/plumbing ☐ Basement wo/plumbing

Water Supply: ☐ Individual ☑ Public ☑ Community


Comments:/Conditions: Install Laterals at 36" trench bottom depth. Do not cut front of house - Backfill against foundation to provide positive drainage

Comments:/Conditions: (PARTIAL) Reviewed Building plans 5/20/03, essential in compliance with original permit. (Plans are for 3 Bedrooms & permit is for 4 Bedrooms)

INITIAL SITE SKETCH

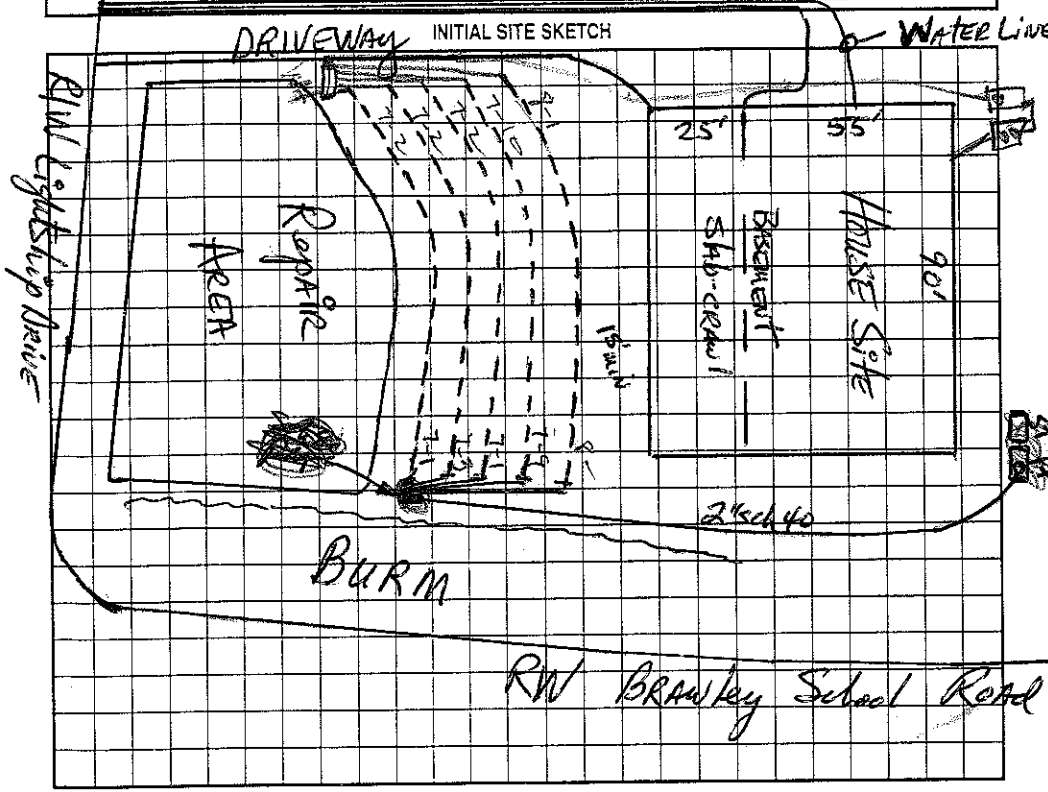

AS BUILT SKETCH

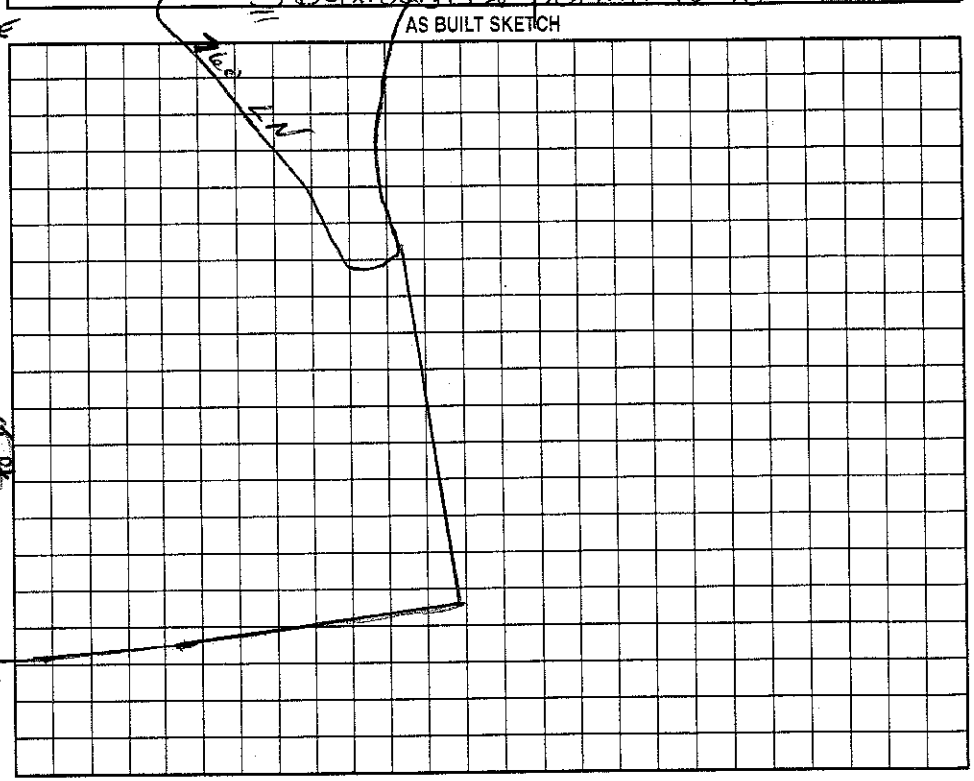

Permit can be suspended or revoked if any false information is supplied toward securing the permit/any unauthorized changes are made to the site/any unauthorized changes are made in the installation of the system. Improvement Permit with plat valid without expiration. Improvement Permit with site plan valid for sixty months. Authorization to Construct is valid for a period equal to that of Improvement Permit – not to exceed sixty months.

Signed: date 10/10/01

Improvement Permit by: date 9-28-01

Authorization to Construct by: date 5/20/03

Installed by: Contract Dependency

Operation Permit by: Wesley Sparks R.S. date 9/9/05

Existing System Inspection by: date

HEALTH DEPT. COPY: WHITE OWNER COPY (FINAL): YELLOW OWNER COPY (INITIAL): PINK