10.00

IREDELL COUNTY HEALTH DEPARTMENT

STATESVILLE 704-878-5305 MOORESVILLE 704-664-5281

IMPROVEMENT PERMIT / AUTHORIZATION TO CONSTRUCT / OPERATION PERMIT / EXISTING SYSTEM INSPECTION

PERMIT# 130695 PIN# 4625515613 DATE 3-18-06

OWNER OR APPLICANT Simonini Builders PHONE: Business Home

ADDRESS 817 E Morehead St. Ste 100 Charlotte NC 28202

LOCATION Brawley School Rd TR Heathland on right near end

SUBDIVISION Point BLOCK / SECTION 8 LOT 808 LOT AREA 32,217+2 SITE CLASS PS DESIGN FLOW 600 L.T.A.R. .3

Septic Tank: 1500 Gallons; STB 444 Date 12-11-06

Pump Tank: 1500 Gallons; PT 444 Date 11-20-06

Pump Make: Myers Model WE=0312HC Serial No.

Nitrification Field: No Fields Square Feet 672 Linear Feet 336

No Lines Lp@56' Trench Width * See note Max Trench Bottom Depth 36 Gravel Depth N/A

☒ New System ☐ Repair ☐ Expansion System Type: I II III IV V VI

System Description: Pump-LP Panel Block

Repair System Description: Same

Maintenance Agreement Required: ☒ Yes ☐ No

☒ House/Mod. Home ☐ Mobile Home ☐ Business ☐ Other

No. Bedrooms 5 No. Persons No. Employees


Water Supply: ☐ Individual ☒ Public ☒ Community

☐ Gravity ☐ Pressure ☐ Slab ☐ Crawl Space ☐ Basement w/plumbing ☐ Basement wo/plumbing

Comments/Conditions: * Trench width - See Crescent Communities On Site Sewage Disposal Manual


* Keep Septic System 10ft from PL, 50 from lake, 15ft from pool & 25' upgradient of basement wall or 15-ft side slope.

INITIAL SITE SKETCH

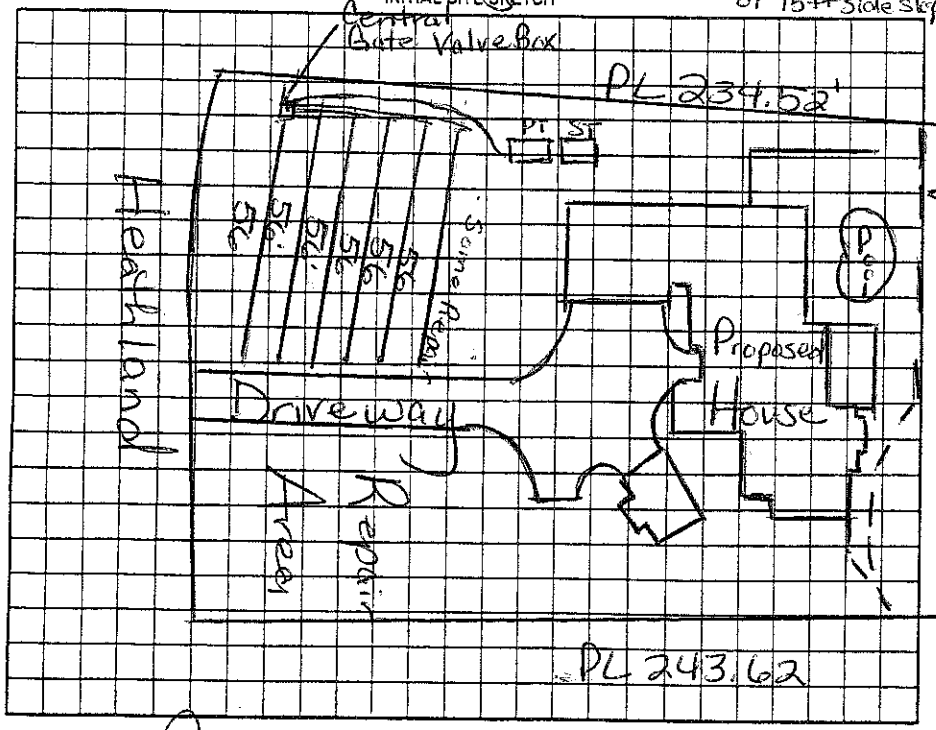

Comments/Conditions: ~ 13 panels per ditch. +Builder using "Grinder pump" for basement plumbing. 2/12/07 Checked tanks & lines

AS BUILT SKETCH

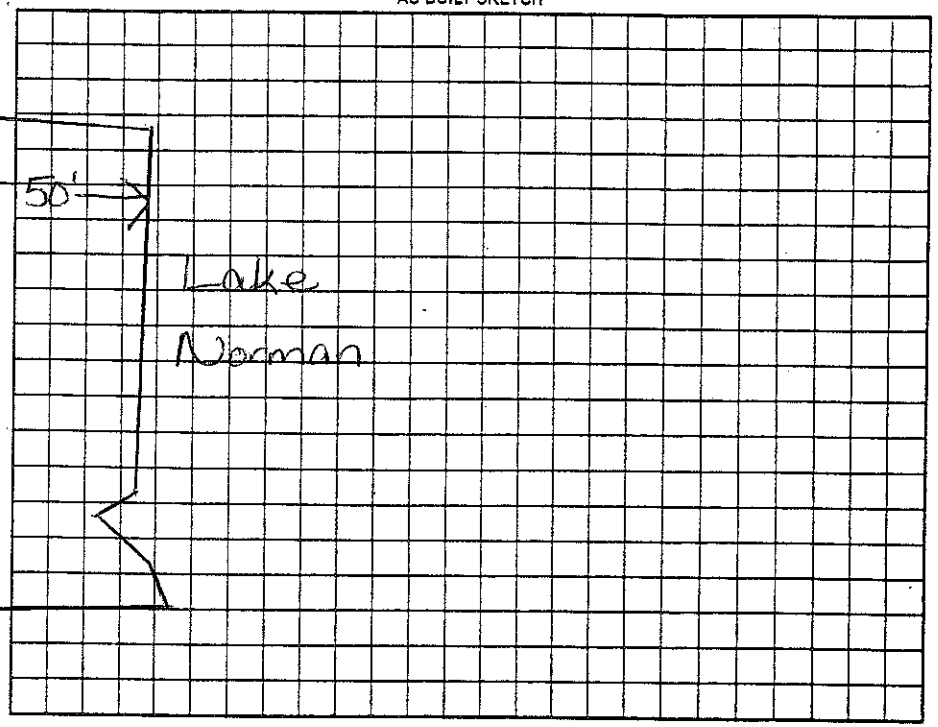

Permit can be suspended or revoked if any false information is supplied toward securing the permit/any unauthorized changes are made to the site/any unauthorized changes are made in the installation of the system. Improvement Permit with plat valid without expiration. ☐ Improvement Permit with site plan valid for sixty months ☐ Authorization to Construct is valid for a period equal to that of Improvement Permit – not to exceed sixty months.

Signed: date 4.20.06

Improvement Permit by: Maria H. Dotson RS date 3/18/06

Authorization to Construct by: Maria H. Dotson RS date 3/18/06

Installed by: RFH RS

Operation Permit by: Maria H. Dotson date 3/9/07

Existing System Inspection by: date

HEALTH DEPT. COPY: WHITE OWNER COPY (FINAL): YELLOW OWNER COPY (INITIAL): PINK