IREDELL COUNTY HEALTH DEPARTMENT

STATESVILLE 704-878-5305 50.00 Paid MOORESVILLE 704-664-5281

IMPROVEMENT PERMIT / AUTHORIZATION TO CONSTRUCT / OPERATION PERMIT / EXISTING SYSTEM INSPECTION

PERMIT# 10186 PIN# ~~4625-99-1684.80~~ 4625-51-7783 DATE 3/5/02

OWNER OR CONTRACTOR Dibble Custom Homes PHONE: Business 704-799-1688 Home

ADDRESS Po Box 2355 Cornelius NC 28031

LOCATION Brawley Sch, TR Heathland On Rt.

SUBDIVISION Point BLOCK / SECTION 8 LOT 806 LOT AREA 49846 Ft² SITE CLASS PS DESIGN FLOW 600 L.T.A.R. 0.3

Septic Tank: 1500 Gallons; STB 338 Date 5/7/02

Pump Tank: 1500 Gallons; PT 338 Date 5/12/02

Pump Make: Goulds Model WE0-512HH Serial No. B015053-5

Nitrification Field: No Fields 1 Square Feet 990 Linear Feet 330

No Lines 6@55' Trench Width 36" Max Trench Bottom Depth 36" Gravel Depth —

☒ New System ☐ Repair System Type: I, II, III, (IV), V, VI

System Description: LP PPBPS

Repair System Description: Same

Maintenance Agreement Required: ☒ Yes ☐ No

☒ House/Mod. Home ☐ Mobile Home ☐ Business ☐ Other

No. Bedrooms 5 No. Bathrooms 4½ No. Employees

☐ Slab ☐ Crawl Space ☒ Basement w/plumbing ☐ Basement wo/plumbing


Water Supply: ☐ Individual ☐ Public ☒ Community

Comments:/Conditions:


Comments:/Conditions:

11/26/02 - CBC Dredging has taken equipment across sewer line between 3rd and house — AWS

INITIAL SITE SKETCH

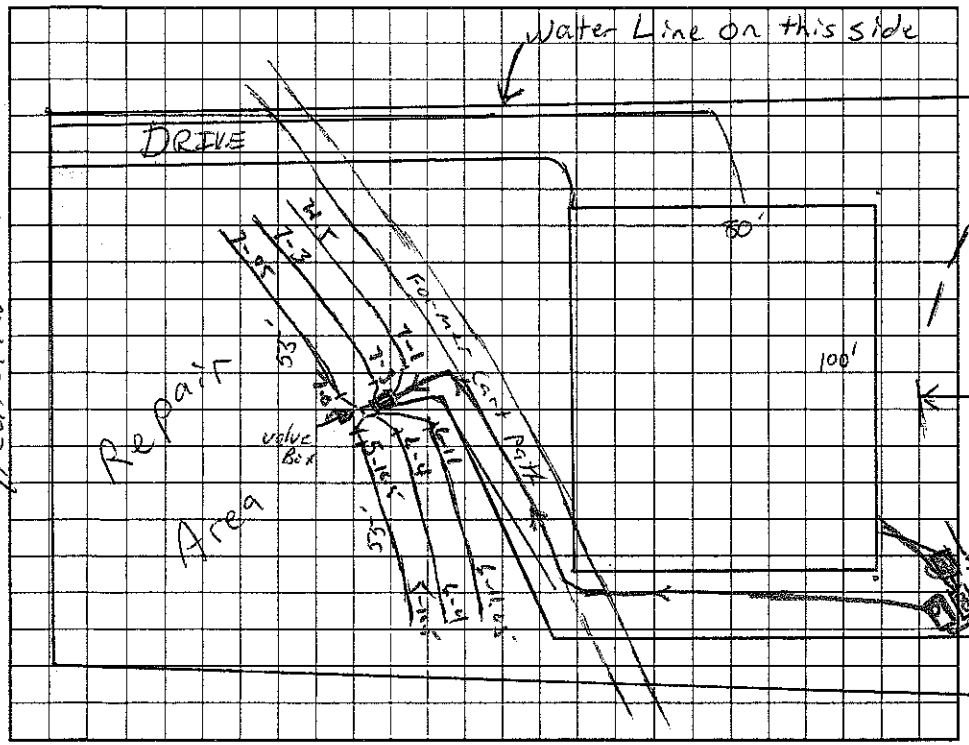

AS BUILT SKETCH

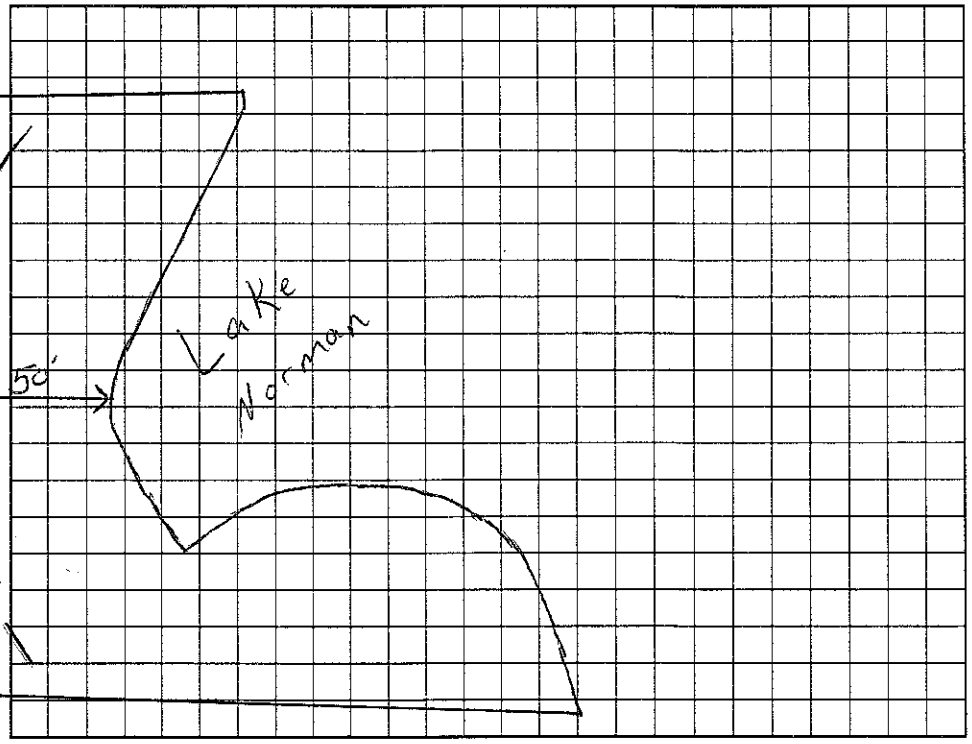

Permit can be suspended or revoked if any false information is supplied toward securing the permit/any unauthorized changes are made to the site/any unauthorized changes are made in the installation of the system. Improvement Permit with plat valid without expiration. Improvement Permit with site plan valid for sixty months. Authorization to Construct is valid for a period equal to that of Improvement Permit – not to exceed sixty months.

Signed: Crystal Dibble date 3/6/02 Installed by: Onbrisom & Sons.

Improvement Permit by: RS date 3/5/02 Operation Permit by: Wesley Sparks RS. date 11/26/02

Authorization to Construct by: RS date 3/5/02 Existing System Inspection by: date

HEALTH DEPT. COPY: WHITE OWNER COPY (FINAL): YELLOW OWNER COPY (INITIAL): PINK