IREDELL COUNTY HEALTH DEPARTMENT

STATESVILLE 704-878-5305 50.00 Paid MOORESVILLE 704-664-5281

IMPROVEMENT PERMIT / AUTHORIZATION TO CONSTRUCT / OPERATION PERMIT / EXISTING SYSTEM INSPECT

PERMIT# 094948 PIN# 4625941684 pt 4625-52-1689 DATE 10-25

OWNER OR CONTRACTOR Elrod Homes PHONE: Business (704) 987-5022 Home

ADDRESS P.O. Box 472112 Charlotte, NC 28247

LOCATION Brawley School Rd TR Athleboro TL Rehoboth at end

SUBDIVISION The Point BLOCK / SECTION 7 LOT 727/727A LOT AREA 27490 + 20764 SITE CLASS PS DESIGN FLOW 600gpd L.T.A.R. ~.25

Septic Tank: 1500 Gallons; STB 338 Date 7/15/03
Pump Tank: 1500 Gallons; PT 338 Date 6/29/03
Pump Make: Gould's Model WFE1512H4 Serial No.
Nitrification Field: No Fields 1 Square Feet 1800' Linear Feet 600'
No Lines 5@120' Trench Width 36" Max Trench Bottom Depth 36" Gravel Depth N/A

☒ New System ☐ Repair System Type: I, II, III, IV, V, VI
System Description: Pump-PM 25% Reduction
Repair System Description: LPP DPBPS
Maintenance Agreement Required: ☐ Yes ☒ No


☒ House/Mod. Home ☐ Mobile Home ☐ Business ☐ Other
No. Bedrooms 5 No. Bathrooms No. Employees
☐ Slab ☐ Crawl Space ☒ Basement w/plumbing ☐ Basement wo/plumbing

Water Supply: ☐ Individual ☒ Public ☒ Community

Comments:/Conditions: Keep Septic System at least 10' from PL & 50' from lake

Comments:/Conditions: Note: Connect to Blue pipe for "off site" access to 727A. Run up take path with to Easement

INITIAL SITE SKETCH

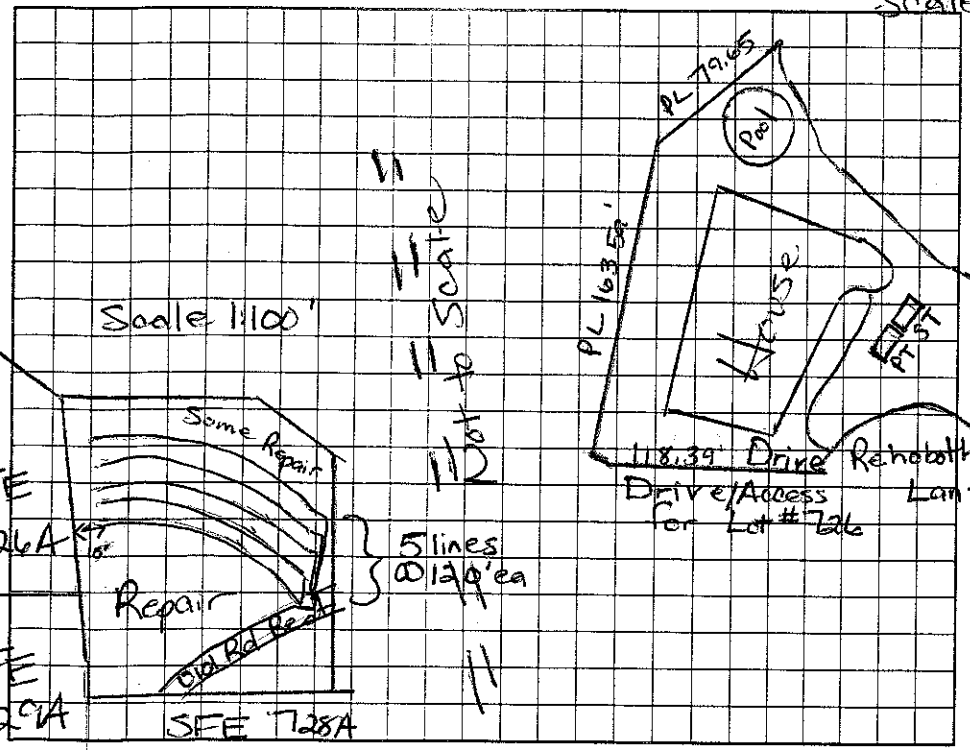

AS BUILT SKETCH

Installed "EZ Flow" Drainfield Checked lines 6/10/03 MP

Permit can be suspended or revoked if any false information is supplied toward securing the permit/any unauthorized changes are made to the site/any unauthorized changes are made in the installation of the system. Improvement Permit with plat valid without expiration. Improvement Permit with site plan valid for sixty months. Authorization to Construct is valid for a period equal to that of Improvement Permit – not to exceed sixty months.

Signed: date Installed by: C. Wayne Orbison

Improvement Permit by: RS date 10/25/02 Operation Permit by: RS date 10/15/03

Authorization to Construct by: RS date 10/25/02 Existing System Inspection by: date

HEALTH DEPT. COPY: WHITE OWNER COPY (FINAL): YELLOW OWNER COPY (INITIAL): PINK