$50 3/00

IREDELL COUNTY HEALTH DEPARTMENT

STATESVILLE 704-878-5305 MOORESVILLE 704-664-5281

IMPROVEMENT PERMIT / AUTHORIZATION TO CONSTRUCT / OPERATION PERMIT / EXISTING SYSTEM INSPECTION

PERMIT# 094953 PIN# ~~4625 94 1664 (pt)~~ 4625-52-4177 DATE Feb 15, 02

OWNER OR CONTRACTOR CRI // Simonini Bldg. PHONE: Business (704) 201-8996 Home

ADDRESS 817 E. Morehead, Charlotte 28202

LOCATION Brawley Sch Rd TR Attleboro TL Rehoboth 8th on left

SUBDIVISION The Point BLOCK / SECTION 7 LOT 731 LOT AREA 42,140 ft² SITE CLASS PS DESIGN FLOW 600 gpd L.T.A.R. .025

Septic Tank: 1500 Gallons; STB 338 Date 5-5-02
Pump Tank: 1500 Gallons; ~~338~~ 1500 Date 10-15-02
Pump Make: Myers Model ME50 Serial No.
Nitrification Field: No. Fields Square Feet 800/1200 Linear Feet 400
No. Lines 4 @ 100 Trench Width 24" MIN Bloc 36" MAX 90c Max Trench Bottom Depth 36" Gravel Depth NA

☑ New System ☐ Repair System Type: I, II, III, IV, V, VI
System Description: LPP BRS
Repair System Description: Same
Maintenance Agreement Required: ☑ Yes ☐ No

☑ House/Mod. Home No. Bedrooms 5
☐ Mobile Home No. Bathrooms 5.5
☐ Business No. Employees
☐ Other
☐ Slab ☐ Crawl Space ☑ Basement w/plumbing ☐ Basement wo/plumbing

Water Supply: ☐ Individual ☑ Public ☑ Community


Comments/Conditions: Do not cut area at sidewalk, Sidewalk not to extend farther than 10' from closest point of house foundation.

This permit Replaces permit issued 5-30-01


Comments/Conditions: 5/32" hole drilled 9/30/02
88 total panels used, lines checked

1" = 50'

INITIAL SITE SKETCH

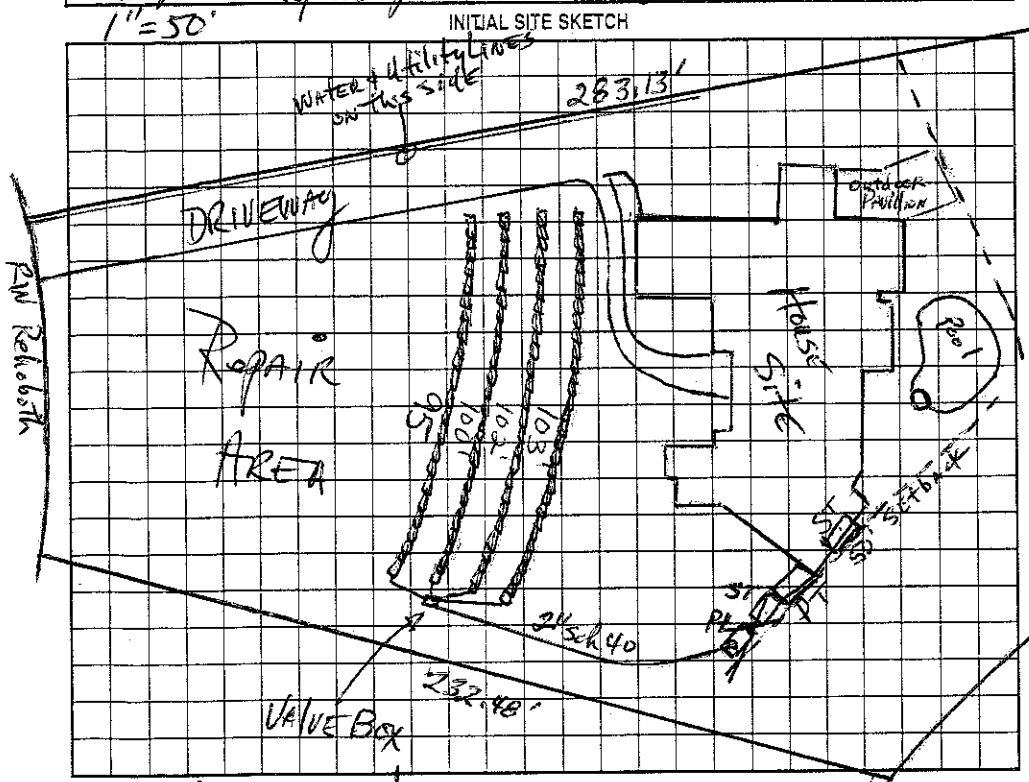

AS BUILT SKETCH

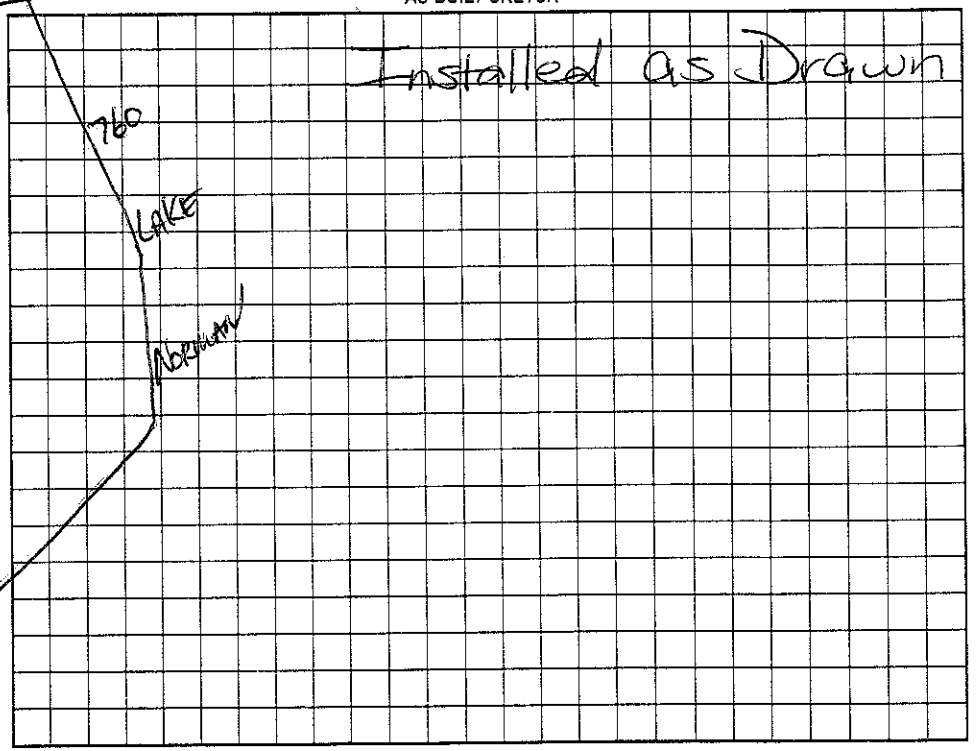

Permit can be suspended or revoked if any false information is supplied toward securing the permit/any unauthorized changes are made to the site/any unauthorized changes are made in the installation of the system. Improvement Permit with plat valid without expiration. Improvement Permit with site plan valid for sixty months. Authorization to Construct is valid for a period equal to that of Improvement Permit – not to exceed sixty months.

Signed: [signature] date 2/13/02 Installed by: R & H Inc.

Improvement Permit by: DR Hanson, RS date 2-15-02 Operation Permit by: [signature] RS date 2/24/03

Authorization to Construct by: DR Hanson, RS date 2-15-02 Existing System Inspection by: date

HEALTH DEPT. COPY: WHITE OWNER COPY (FINAL): YELLOW OWNER COPY (INITIAL): PINK