4:06

IREDELL COUNTY HEALTH DEPARTMENT

STATESVILLE 704-878-5305 MOORESVILLE 704-664-5281

IMPROVEMENT PERMIT / AUTHORIZATION TO CONSTRUCT / OPERATION PERMIT / EXISTING SYSTEM INSPECTION

PERMIT# 094945 PIN# 4625941684(pt) 4625-52-7405 DATE 10-28-2002

OWNER OR CONTRACTOR Tom Stevenson Building Co. PHONE: Business 660-6638 Home Dale 201-7273

ADDRESS 631 Brawley School Rd Suite 503 Mooresville, NC 28117

LOCATION Brawley School Rd TR Attleboro TL Rehoboth lot on right

SUBDIVISION The Point BLOCK / SECTION 7 LOT 724 LOT AREA ______ SITE CLASS. PS DESIGN FLOW 480gpd L.T.A.R. ______

Septic Tank: 1000+ Gallons; STB 338 Date 9-12-02
Pump Tank: 1000 Gallons; PT 3327 Date 10-5-02
Pump Make: ______ Model ______ Serial No. ______
Nitrification Field: No Fields 1 Square Feet 1260 Linear Feet 420'
No Lines 6 @ 70' Trench Width 36" Max Trench Bottom Depth 36" Gravel Depth N/A

☒ New System ☐ Repair System Type: I, II, (III), IV, V, VI
System Description: Pump-PM-25% Reduction
Repair System Description: Pump-LP-Panel Blk
Maintenance Agreement Required: ☐ Yes ☒ No
☐ Slab ☒ Crawl Space ☒ Basement w/plumbing ☐ Basement wo/plumbing

☒ House/Mod. Home ☐ Mobile Home ☐ Business ☐ Other
No. Bedrooms 4 No. Bathrooms 5½ No. Employees ______

Water Supply: ☐ Individual ☒ Public ☒ Community


Comments:/Conditions:

Comments:/Conditions: Keep Septic System at least 10' to PL, 50' to lake, 15' to Future pool & 25' from basement wall

Checked lines 11/20/2002
Tanks checked 11/22/02

Scale 1":40'

INITIAL SITE SKETCH

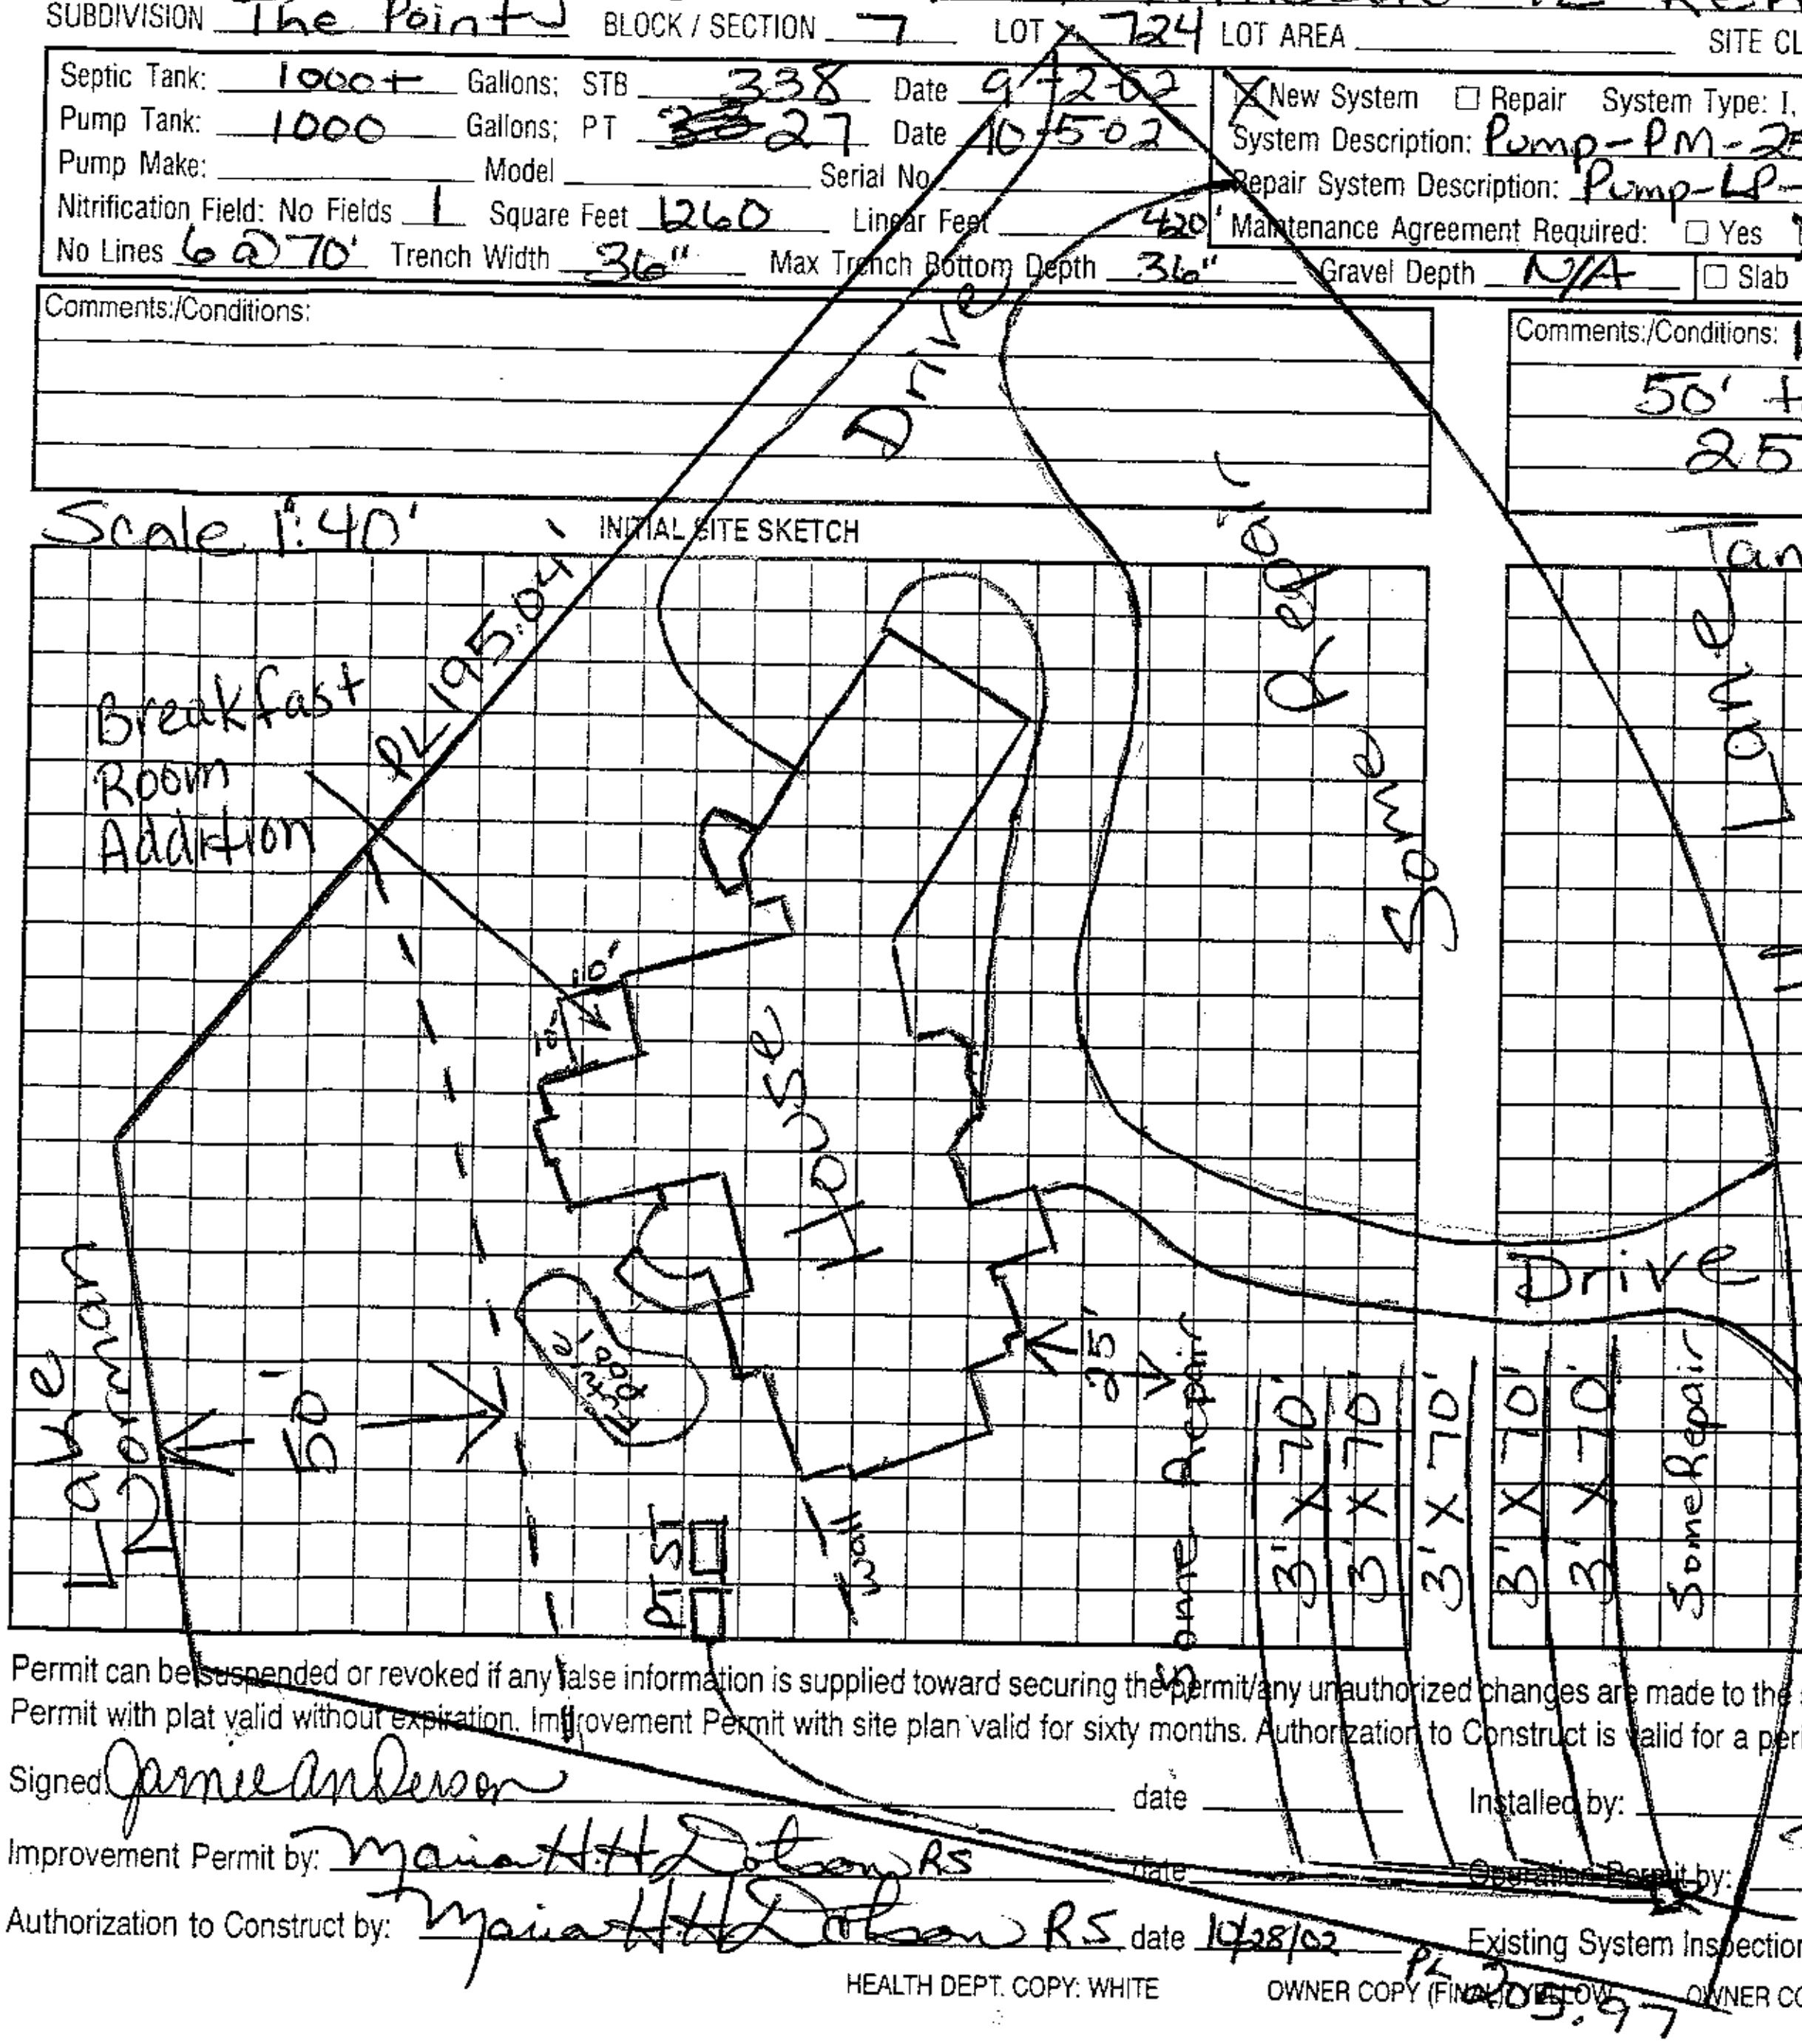

AS BUILT SKETCH

Note: 3 Ft of risers & dirt on top of tanks
Pressure, elect, alarm 3/12/03
EZ Flow lines installed

Location of the proposed Breakfast Room addition does not appear to impact the existing on-site septic system.**NOTE: ______

Andy Mulick REHS
Date: 6-6-11
ICHD-Environmental Health Division

Permit can be suspended or revoked if any false information is supplied toward securing the permit/any unauthorized changes are made to the site/any unauthorized changes are made in the installation of the system. Improvement Permit with plat valid without expiration. Improvement Permit with site plan valid for sixty months. Authorization to Construct is valid for a period equal to that of Improvement Permit – not to exceed sixty months.

Signed Jamie Anderson date ______ Installed by: R & H Inc.

Improvement Permit by: Maria H H Dotson RS date ______ Operation Permit by: Maria H H Dotson RS date 3/12/03

Authorization to Construct by: Maria H H Dotson RS date 10/28/02 Existing System Inspection by: ______ date ______

HEALTH DEPT. COPY: WHITE OWNER COPY (FINAL): YELLOW OWNER COPY (INITIAL): PINK