IREDELL COUNTY HEALTH DEPARTMENT

STATESVILLE 704-878-5305 200.00 Paid MOORESVILLE 704-664-5281

IMPROVEMENT PERMIT / AUTHORIZATION TO CONSTRUCT / OPERATION PERMIT / EXISTING SYSTEM INSPECTION

PERMIT# 094955 PIN# ~~4625 94 1684 Pt.~~ 4625-52-8128 DATE 1/25/02

OWNER OR CONTRACTOR Hughes + Assoc. PHONE: Business 704-895-7805 Home

ADDRESS 10602 Bailey Rd. Suite A Cornelius, NC. 28031

LOCATION Brawley Sch Rd. TR Hillsboro Tr Rehoboth Rd. on (L)

SUBDIVISION Pointe BLOCK / SECTION 7 LOT 733/733A LOT AREA SITE CLASS. PS DESIGN FLOW 600 L.T.A.R. .25

Septic Tank: 1500 Gallons; STB 338 Date 7-12-02
Pump Tank: 1500 Gallons; PT 338 Date 7-20-02
Pump Make: Model Serial No.
Nitrification Field: No Fields 1 Square Feet 800 Linear Feet 400
No Lines 4 @ 100' Trench Width 2-3' Max Trench Bottom Depth 36" Gravel Depth NA

[X] New System [ ] Repair System Type: I, II, III, (IV), V, VI
System Description: Pres Dosed 16" PPBPS
Repair System Description: SAME
Maintenance Agreement Required: [X] Yes [ ] No

[X] House/Mod. Home No. Bedrooms 5
[ ] Mobile Home No. Bathrooms 4
[ ] Business No. Employees
[ ] Other
[ ] Slab [ ] Crawl Space [X] Basement w/plumbing [ ] Basement wo/plumbing


Water Supply: [ ] Individual [X] Public [X] Community

Comments:/Conditions:

Comments:/Conditions: 5/32" hole drilled
Tanks checked 8/22/02
Drilled 5/32" hole
Tanks, pressure, elect. alarm checked by MD

(1"=100')

INITIAL SITE SKETCH

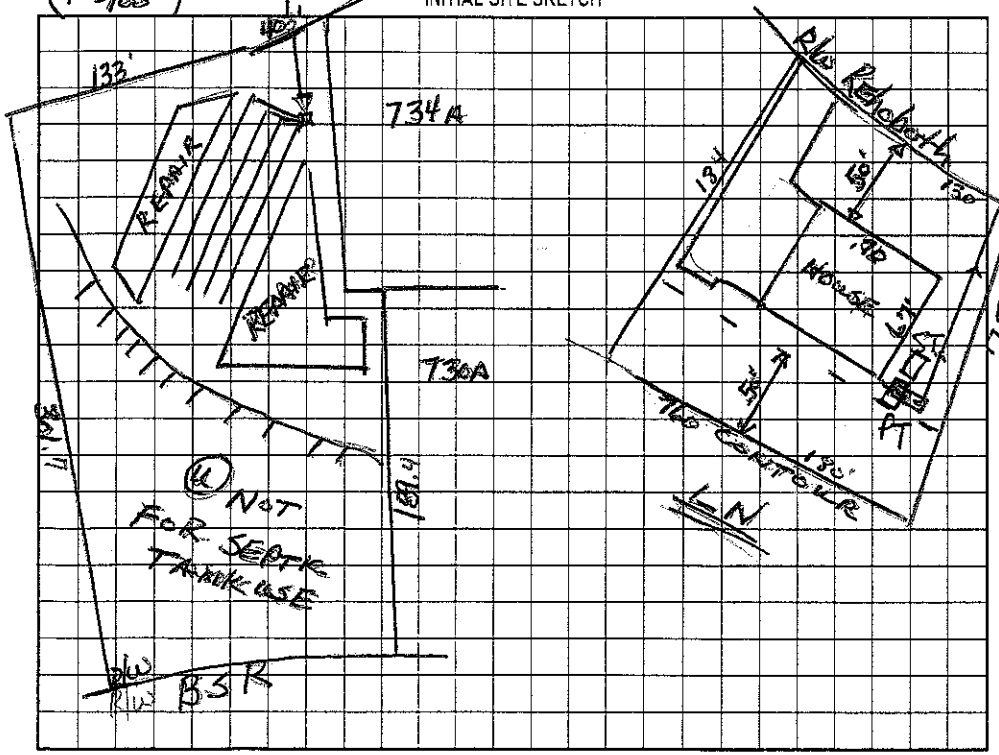

AS BUILT SKETCH

Lines checked by GM

Permit can be suspended or revoked if any false information is supplied toward securing the permit/any unauthorized changes are made to the site/any unauthorized changes are made in the installation of the system. Improvement Permit with plat valid without expiration. Improvement Permit with site plan valid for sixty months. Authorization to Construct is valid for a period equal to that of Improvement Permit – not to exceed sixty months.

Signed: * Bill Poplin date 1-31-02 Installed by: R & H Inc. RS

Improvement Permit by: Wesley Sparks R.S. date 1/25/02 Operation Permit by: Maria H. Dickson date 12/16/2002

Authorization to Construct by: Wesley Sparks R.S. date 1/25/02 Existing System Inspection by: date

HEALTH DEPT. COPY: WHITE OWNER COPY (FINAL): YELLOW OWNER COPY (INITIAL): PINK