$245.00 2:30

IREDELL COUNTY HEALTH DEPARTMENT

STATESVILLE 704-878-5305 MOORESVILLE 704-664-5281

IMPROVEMENT PERMIT / AUTHORIZATION TO CONSTRUCT / OPERATION PERMIT / EXISTING SYSTEM INSPECTION

PERMIT# 094956 PIN# 4625-94-1684 DATE

OWNER OR CONTRACTOR David Pibble Custom Homes PHONE: Business 704-799-1688 Home

ADDRESS PO Box 2355 Cornelius NC 28031

LOCATION Brawley Sch TR Attleboro TL Rehoboth on LT

SUBDIVISION Point BLOCK / SECTION 7 LOT 734/7344 LOT AREA 31798ft² + 21807ft² SITE CLASS. P.S DESIGN FLOW 600 L.T.A.R. 0.3

Septic Tank: 1500 Gallons; STB 338 Date 3/23/03
Pump Tank: 1500 Gallons; PT 338 Date 3-22-03
Pump Make: Model Serial No.
Nitrification Field: No Fields 1 Square Feet 990 Linear Feet 330
No Lines 3 Trench Width 36" Max Trench Bottom Depth 36" Gravel Depth —

☒ New System ☐ Repair System Type: I, II, III, (IV), V, VI
System Description: LP Pump / Block
Repair System Description: same
Maintenance Agreement Required: ☒ Yes ☐ No


☒ House/Mod. Home No. Bedrooms 5
☐ Mobile Home No. Bathrooms 5
☐ Business No. Employees
☐ Other
☐ Slab ☐ Crawl Space ☒ Basement w/plumbing ☐ Basement wo/plumbing

Water Supply:
☐ Individual
☐ Public
☒ Community


Comments:/Conditions:

Comments:/Conditions: pt checked 5/6/03

INITIAL SITE SKETCH

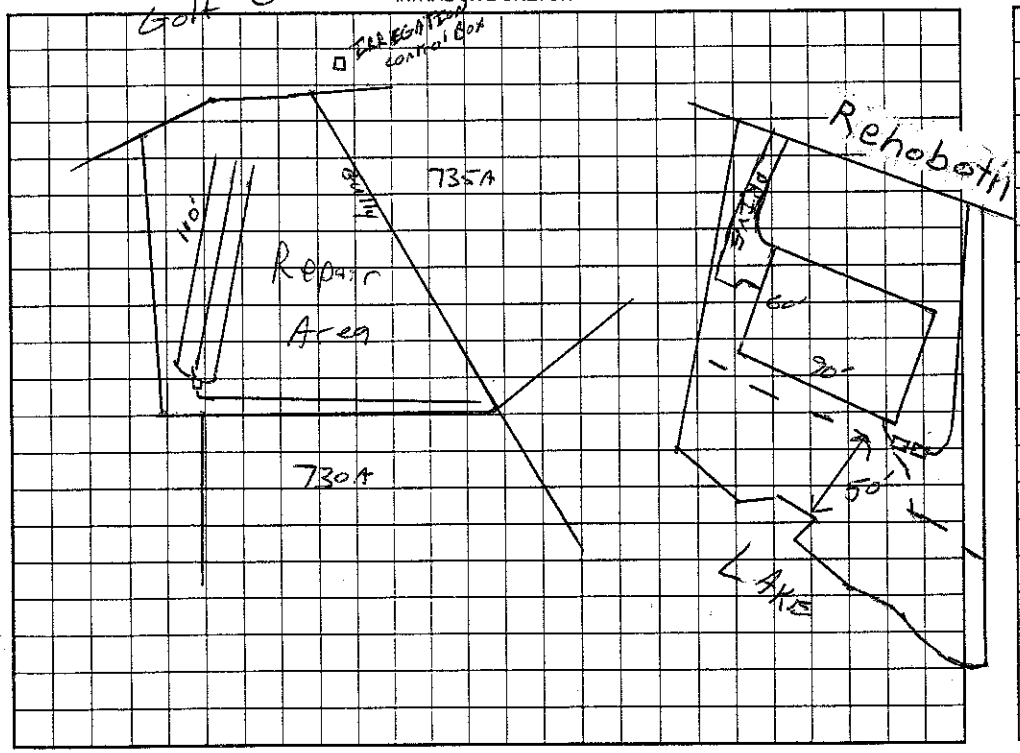

AS BUILT SKETCH

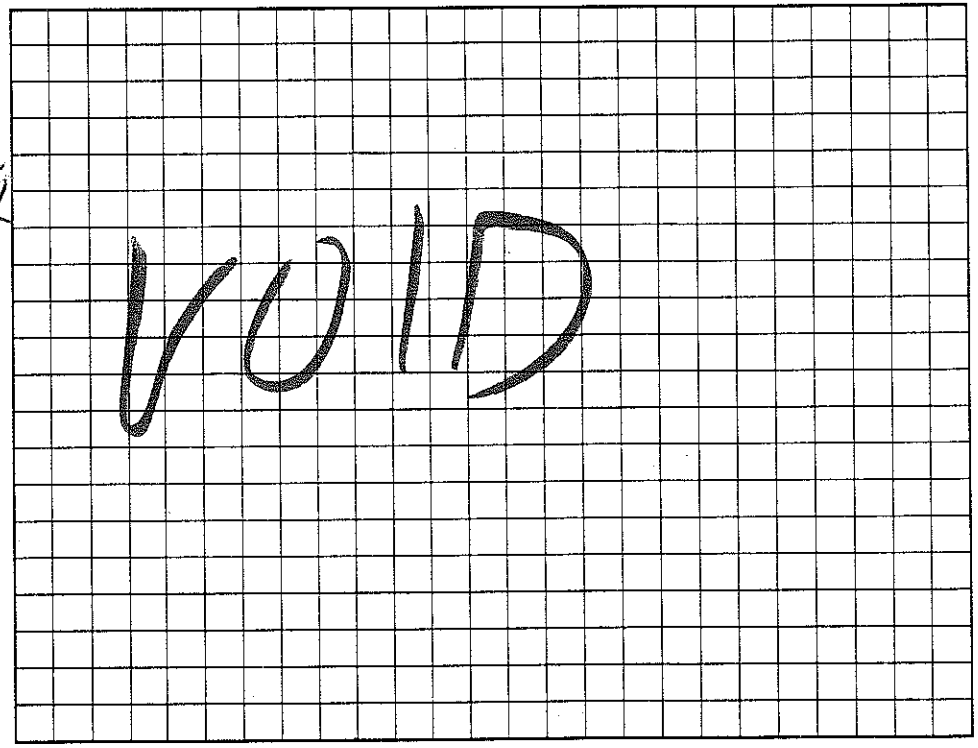

Permit can be suspended or revoked if any false information is supplied toward securing the permit/any unauthorized changes are made to the site/any unauthorized changes are made in the installation of the system. Improvement Permit with plat valid without expiration. Improvement Permit with site plan valid for sixty months. Authorization to Construct is valid for a period equal to that of Improvement Permit – not to exceed sixty months.

Signed: Crystal D Rose date

Improvement Permit by: RS date 2/4/03

Authorization to Construct by: RS date 2/4/03

Installed by: C. Wayne Orbison

Operation Permit by: date

Existing System Inspection by: date

HEALTH DEPT. COPY: WHITE OWNER COPY (FINAL): YELLOW OWNER COPY (INITIAL): PINK