IREDELL COUNTY HEALTH DEPARTMENT

STATESVILLE 704-878-5305 50.00 Paid MOORESVILLE 704-664-5201

IMPROVEMENT PERMIT / AUTHORIZATION TO CONSTRUCT / OPERATION PERMIT / EXISTING SYSTEM INSPECTION

PERMIT# 094456 PIN# 4625-94-1684 4625-52-9272 DATE

OWNER OR CONTRACTOR David Dibble Custom Homes PHONE: Business 704 799 1688 Home

ADDRESS PO Box 2355 Cornelius NC 28031

LOCATION BSR, TR Attleboro, TL Rehoboth on Lt.

SUBDIVISION Point BLOCK / SECTION 7 LOT 734/154A LOT AREA 31799 Ft²/21907 Ft² SITE CLASS. PS DESIGN FLOW 600 L.T.A.R. 0.3

Septic Tank: 1500 Gallons; STB 338 Date 3/23/03

Pump Tank: 1500 Gallons; PT 338 Date 3/22/03

Pump Make: Goulds Model WE1012HH Serial No. 5026342 4

Nitrification Field: No Fields 1 Square Feet 1500 Linear Feet 500

No Lines 4@125' Trench Width 36" Max Trench Bottom Depth 36" Gravel Depth —

☒ New System ☐ Repair System Type: I, II, III, IV, V, VI

System Description: Press. Man. 25% Red.

Repair System Description: LP Panel Block

Maintenance Agreement Required: ☐ Yes ☒ No

☒ House/Mod. Home ☐ Mobile Home ☐ Business ☐ Other

No. Bedrooms 5 No. Bathrooms 5 No. Employees


☐ Slab ☐ Crawl Space ☒ Basement w/plumbing ☐ Basement wo/plumbing

Water Supply: ☐ Individual ☐ Public ☒ Community

Comments:/Conditions:

Comments:/Conditions:

INITIAL SITE SKETCH

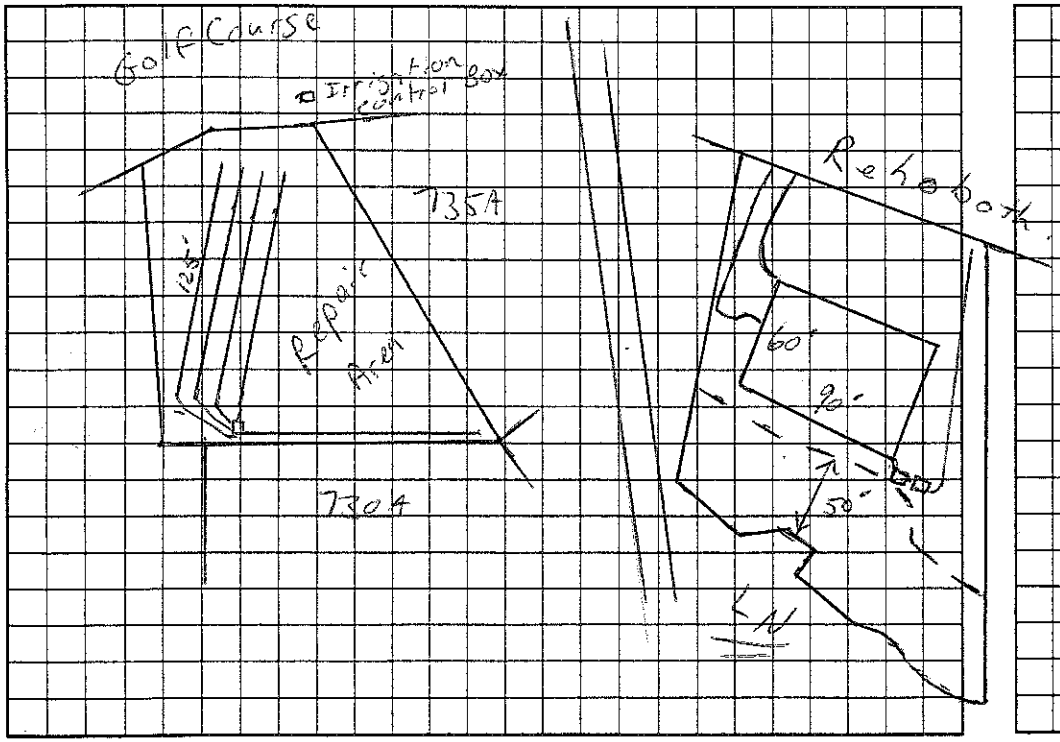

AS BUILT SKETCH

Inf. Trenches Installed

As Drawn

The proposed / existing ADDITION addition does not appear to impact the existing septic system.

**NOTE: SEE ATTACHED

REHS

Date: 5-10-06

ICHD-Environmental Health Division

Permit can be suspended or revoked if any false information is supplied toward securing the permit/any unauthorized changes are made to the site/any unauthorized changes are made in the installation of the system. Improvement Permit with plat valid without expiration. Improvement Permit with site plan valid for sixty months. Authorization to Construct is valid for a period equal to that of Improvement Permit – not to exceed sixty months.

Signed: Crystal D. [illegible] date 6/2/03

Improvement Permit by: [signature] RS date 6/2/03

Authorization to Construct by: [signature] RS date 6/2/03

Installed by: Orbison

Operation Permit by: [signature] RS date 6/6/03

Existing System Inspection by: date

HEALTH DEPT. COPY: WHITE OWNER COPY (FINAL): YELLOW OWNER COPY (INITIAL): PINK