121809 $125 12/00

IREDELL COUNTY HEALTH DEPARTMENT

STATESVILLE 704-878-5305 MOORESVILLE 704-664-5281

IMPROVEMENT PERMIT / AUTHORIZATION TO CONSTRUCT / OPERATION PERMIT / EXISTING SYSTEM INSPECTION

PERMIT# 094932 ✓ PIN# 4625 94 1684 (pt) 4625537007 DATE June 7, 01

OWNER OR CONTRACTOR Crescent Resources clo/ Dienst PHONE: Business Home

ADDRESS PO Box 1003 Charlotte N.C. 28201

LOCATION Brawley Sch Rd. TR Attleboro at end 192 Attleboro Pl

SUBDIVISION The Point BLOCK / SECTION 7 LOT 714/714A LOT AREA 41,674 + 19923 sf SITE CLASS. RS DESIGN FLOW 600gpd L.T.A.R. 83

Septic Tank: 1500 / 1500 Gallons; STB 338 Date 2-17-05

Pump Tank: Gallons; PT 27 Date 2-18-05

Pump Make Myers Model ~~PIOE~~ ME50 Serial No.

Nitrification Field: No. Fields 1 Square Feet 1626 Linear Feet 540

No Lines 6@90' Trench Width 36" Max Trench Bottom Depth 36" Gravel Depth NA

☑ New System ☐ Repair System Type: I, II, III, IV, V, VI

System Description: 2pm INNOVATIVE-25% Red.

Repair System Description: LA Innovative or PPBPS

Maintenance Agreement Required: ☐ Yes ☑ No Initiative

☐ House/Mod. Home ☐ Mobile Home ☐ Business ☐ Other

No. Bedrooms 5 No. Bathrooms 4 No. Employees

☐ Slab ☐ Crawl Space ☑ Basement w/plumbing ☐ Basement wo/plumbing


Water Supply: ☐ Individual ☑ Public ☑ Community

Comments:/Conditions: Reviewed Building plans & site plan; essentially in Conformance with orginal permit.


Comments:/Conditions: ~~X~~ Note: Will have to run supply line along other side of house due to pool

Checked tanks 12/26/05.

INITIAL SITE SKETCH

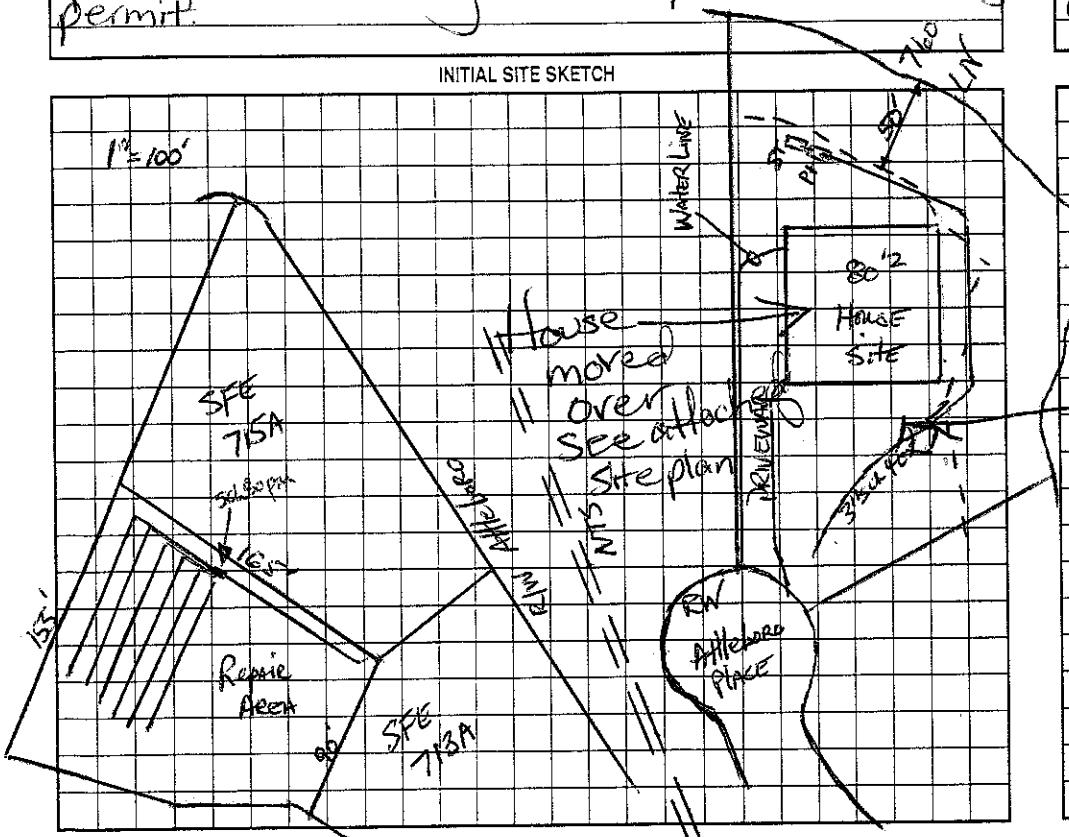

AS BUILT SKETCH

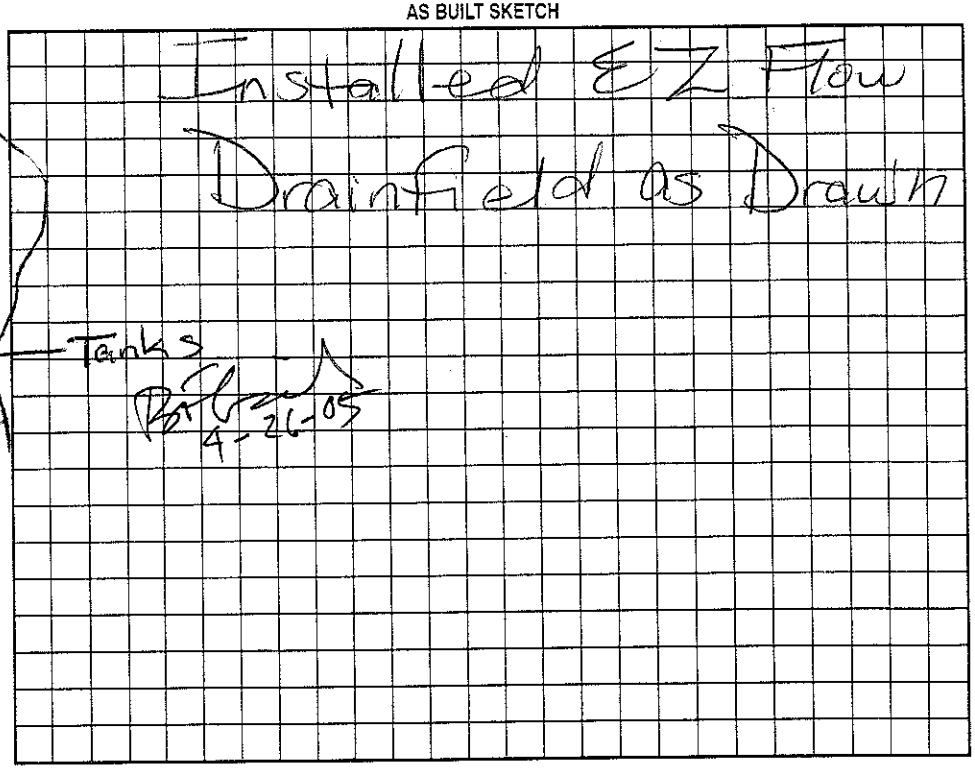

Permit ~~can be suspended~~ or revoked if any false information is supplied toward securing the permit/any unauthorized changes are made to the site/any unauthorized changes are made in the installation of the system. Improvement Permit with plat valid without expiration. Improvement Permit with site plan valid for sixty months. Authorization to Construct is valid for a period equal to that of Improvement Permit – not to exceed sixty months.

Signed: R.S. date 6-15-05 Installed by: R.S.

Improvement Permit by: R.S. date 6-7-05 Operation Permit by: R.S. date 5/18/05

Authorization to Construct by: R.S. date 6/8/05 Existing System Inspection by: date

HEALTH DEPT. COPY: WHITE OWNER COPY (FINAL): YELLOW OWNER COPY (INITIAL): PINK